


Form 51-5M-3-35-Mid-West

Map No. KANSAS Sec. 32 Twp. 19 R. 10-W
 Well No. #4 Wendel Farm
Bradley Oil Company

NORTH

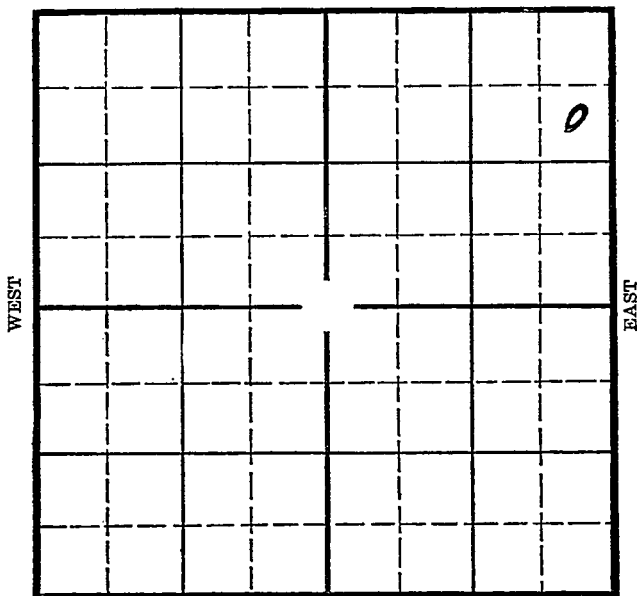

SOUTH

Location _____

Drilling Remarks _____

Rig Up _____

Drilling Remarks _____

RECORD

Cased _____ in. _____ ft.

Sand _____

Gas _____

Oil _____

Total Depth _____

PRODUCTION

1st 24 hrs. Nat. _____

1st 24 hrs. after shot _____

Gas _____ cu. ft. _____

Dry Hole _____

Abandoned _____

KANSAS

Map No. _____ Sec. 32 Twp. 19 R. 10W

Well No. 4- Wendel Farm _____

Bradley Oil Company _____


990 Ft. from N. Line

_____ Ft. from S. Line

330 Ft. from E. Line

_____ Ft. from W. Line

Elev. 1789

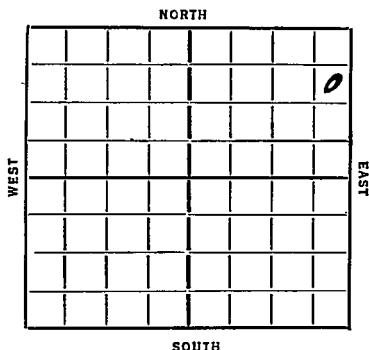

REPORT

1956
2/19 Dig Celler
2/28 Rig
3/6 Rig
3/13 10" 198 woc
3/20 Drlg. 1985
3/27 Drlg. 3000'
4/2 T. Sil. 3282' 6"-3284' Drlg. 3290'
 2500' oil.
4/8 Sil 3282
 TD 3297
 pot 1744.

COMPLETED

KANSAS

Map No. 46 Sec. 32 Twp. 19 R. 10WWell No. 4-WendelBradley oil Company

Contractor

SECTION PLAT

990 Ft. from N. Line

Ft. from S. Line

330 Ft. from E. Line

Ft. from W. Line

			o

Location

Rig up

Drilling and Remarks:

Dig cellar

RECORD

Cased _____ in., _____ ft.

Sand _____

Gas _____

Oil _____

Total Depth _____

PRODUCTION

1st 24 hrs. Nat. _____

1st 24 hrs. after shot _____

Gas _____ Cu. Ft.

Dry Hole _____

Abandoned _____

Date

ORVAL MANNSCHECK

2-19-36 192 _____ Scout

Map No. 46 Sec. 32 Twp. 19 R. 10 NWell No. 4 HendelBradley Oil Company

Contractor

SECTION PLAT990 Ft. from N. Line

Ft. from S. Line

330 Ft. from E. Line

Ft. from W. Line

			0

COMPLETED

Location

Rig up

Drilling and Remarks:

Oil 8282Potential1744**RECORD**

Cased in., ft.

Sand

Gas

Oil

Total Depth 3297**PRODUCTION**

1st 24 hrs. Nat.

1st 24 hrs. after shot

Gas Cu. Ft.

Dry Hole

Abandoned

Date

4/8/36

192

S. J. LEWIS

Scout