


Rice

Form 51-5M-3-35-Mid-West

Map No. KANSAS Sec. 32 Twp. 19 R. 10-WWell No. #5 Wendel Farm
Bradley Oil Republic O.G. Company

NORTH

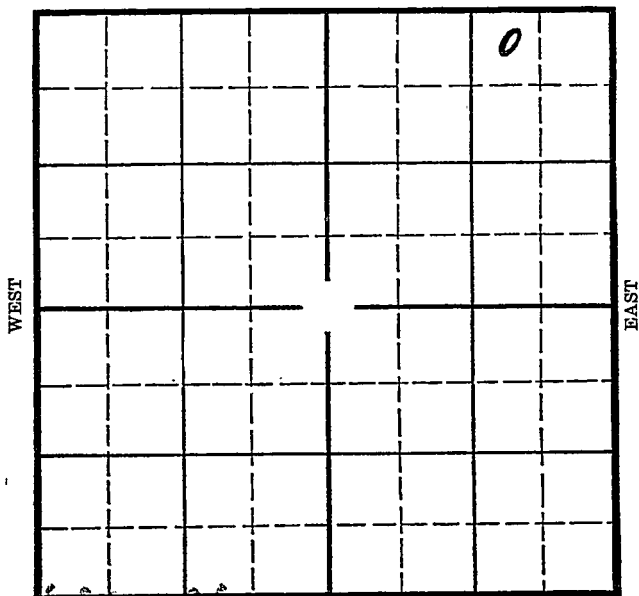

Location _____

Drilling Remarks _____

Rig Up _____

Drilling Remarks _____

RECORD

Cased _____ in. _____ ft.

Sand _____

Gas _____

Oil _____

Total Depth _____

PRODUCTION

1st 24 hrs. Nat. _____

1st 24 hrs. after shot _____

Gas _____ cu. ft. _____

Dry Hole _____

Abandoned _____

Map No. **KANSAS** Sec. 32 Twp. 19 R. 10-W

Well No. 5-Wendel Farm

~~Bradley Oil~~ *Republic Oil Co.* Company

330 Ft. from N. Line

Ft. from S. Line

990 Ft. from E. Line

Ft. from W. Line

Elev. 1788

NORTH									
									0
SOUTH									

Date
1936**SPECIAL**

REPORT

3/25	Rigging rotary
4/2	10"- 212' Woc.
4/10	Drlg. 2100'
4/16	Drlg. 3140'
4/23	3318 Set 7" RUST.
4/30	--
5/7	Sil. 3340'-42'. No show.
5/14	3346' bailing.
5/21	T.D. 3345'. 2000' oil in hole.
5/28	T.D. 3346'. 2400' oil. Acidize.
6/4	Would not take acid. S.D.
6/11	--6/18-- 6/25--7/2--7/9--7/16--
7/23	--7/30--
8/6	Cleaning out.
8/13	Shut down.
8/20	Pump 165 bbls of oil natural in 24 hours.
8/27	Shut down.
9/3	--
9/23	36-Sil. 3340'. T.D. 3347'. Potential 163 bbls of oil.

COMPLETED

SPECIAL

Map No. 46 Sec. 32 Twp. 19 R. 10WWell No. 5 HendelBradley Oil Company

Contractor

SPECIAL

SECTION PLAT

326 Ft. from N. Line

Ft. from S. Line

990 Ft. from E. Line

Ft. from W. Line

FIRST REPORTS

			0

Location

Rig up

Drilling and Remarks:

Rigging R. & T. Co.

RECORD

Cased _____ in., _____ ft.

Sand _____

Gas _____

Oil _____

Total Depth _____

PRODUCTION

1st 24 hrs. Nat. _____

1st 24 hrs. after shot _____

Gas _____ Cu. Ft.

Dry Hole _____

Abandoned _____

Date

8/25/26 192

S. J. LEWIS Scout

Map No. 46 Sec. 32 Twp. 19 R. 10WWell No. 5 WendellRepublic Oil & Gas Company

Contractor

SECTION PLAT

			0

380 Ft. from N. Line

_____ Ft. from S. Line

990 Ft. from E. Line

_____ Ft. from W. Line

CORRECTION

Location _____

Rig up _____

Drilling and Remarks:

*Bradley Oil Co
sold this lease
to Republic Oil
Gas Co..*

RECORD

Cased _____ in., _____ ft.

Sand _____

Gas _____

Oil _____

Total Depth _____

PRODUCTION

1st 24 hrs. Nat. _____

1st 24 hrs. after shot _____

Gas _____ Cu. Ft.

Dry Hole _____

Abandoned _____

Date

S. J. LEWIS

SEP 16 1936 19 _____ Scout

KANSAS

Map No. 46 Sec. 32 Twp. 19 R. 10WWell No. 5 Henole 6Republic Oil Co. CompanyH. J. Lewis Contractor

SECTION PLAT

			0

330 Ft. from N. Line

_____ Ft. from S. Line

990 Ft. from E. Line

_____ Ft. from W. Line

COMPLETED

Location _____

Rig up _____

Drilling and Remarks:

Si 3340P 4163

RECORD

Cased _____ in., _____ ft.

Sand _____

Gas _____

Oil _____

Total Depth 3347

PRODUCTION

1st 24 hrs. Nat. _____

1st 24 hrs. after shot _____

Gas _____ Cu. Ft.

Dry Hole _____

Abandoned _____

Date

SEP 23 1936

19

S. J. LEWIS

Scout