


Map No. KANSAS Sec. 32 Twp. 19 R. 10WWell No. #6 Wendel FarmHutchinson Oil Company

NORTH

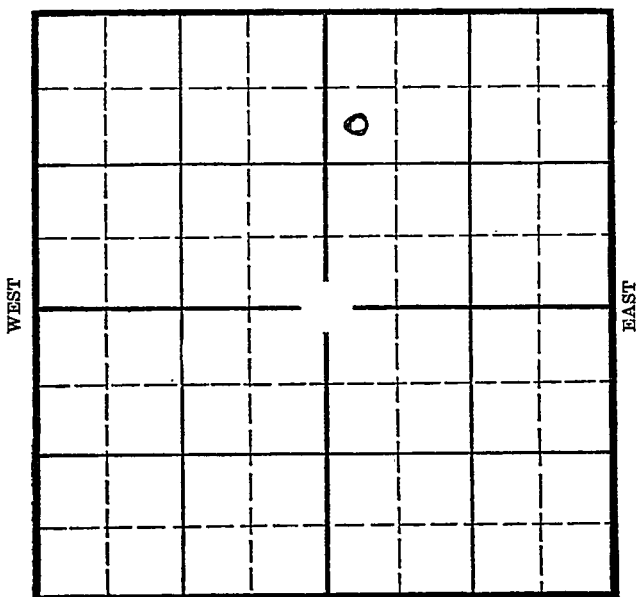

SOUTH

Location _____

Drilling Remarks _____

Rig Up _____

Drilling Remarks _____

RECORD

Cased _____ in. _____ ft.

Sand _____

Gas _____

Oil _____

Total Depth _____

PRODUCTION


1st 24 hrs. Nat. _____

1st 24 hrs. after shot _____

Gas _____ cu. ft. _____

Dry Hole _____

Abandoned _____

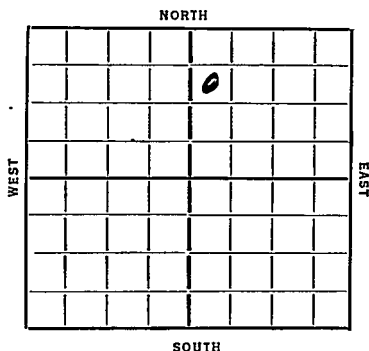Map No. Sec. 32 Twp. 19 R. 10-WWell No. 6-Wendel Farm Hutchinson Oil Company 990 Ft. from N. Line Ft. from S. Line Ft. from E. Line330 Ft. from W. LineElev. ~~1796~~ 1806Date
1936

REPORT

4/8 R.O.G.

4/16 -- 4/23-- 4/30-- 5/7-- 5/14 00

5/21 Rigging up.

5/28 --

6/4 10" @ 167'. Waiting on cement.

6/11 Drlg. 2805'.

7/8/36-Sil. 3300'.

T.D. 3318'.

Pump 1831 bbls of oil natural.

COMPLETED

KANSAS

Map No. *46* Sec. *32* Twp. *19* R. *10 W*Well No. *6 Wendel**Hutchinson Oil* Company

Contractor

SECTION PLAT

990 Ft. from N. Line

Ft. from S. Line

Ft. from E. Line

300 Ft. from W. Line

FIRST REPORT

		o	

Location.....

Rig up.....

Drilling and Remarks:

ROG.

RECORD

Cased.....in., ...ft.

Sand.....

Gas.....

Oil.....

Total Depth.....

PRODUCTION

1st 24 hrs. Nat.....

1st 24 hrs. after shot.....

Gas.....Cu. Ft.

Dry Hole.....

Abandoned.....

Date

4/8/36

192

S. J. LEWIS

Scout

KANSAS

Form 26—AM Bks.—2-29

Map No. 46 Sec. 32 Twp. 19 R. 10 WWell No. 6 HendelHutchinson Oil Company

Contractor

SECTION PLAT

990 Ft. from N. Line

_____ Ft. from S. Line

_____ Ft. from E. Line

330 Ft. from W. Line

COMPLETED

		0	

Location _____

Rig up _____

Drilling and Remarks:

Oil 3300Pump 1831 Nat.

RECORD

Cased _____ in., _____ ft.

Sand _____

Gas _____

Oil _____

Total Depth 3318

PRODUCTION

1st 24 hrs. Nat. _____

1st 24 hrs. after shot _____

Gas _____ Cu. Ft.

Dry Hole _____

Abandoned _____

Date

JUL 8 1935

19

S. J. LEWIS Scout