

KANSAS


Rice

Form 51-5M-4-36-Palace

Section 32 Township 19 Range 10-W

Well Number 6-Wendel

Company Bradley Oil

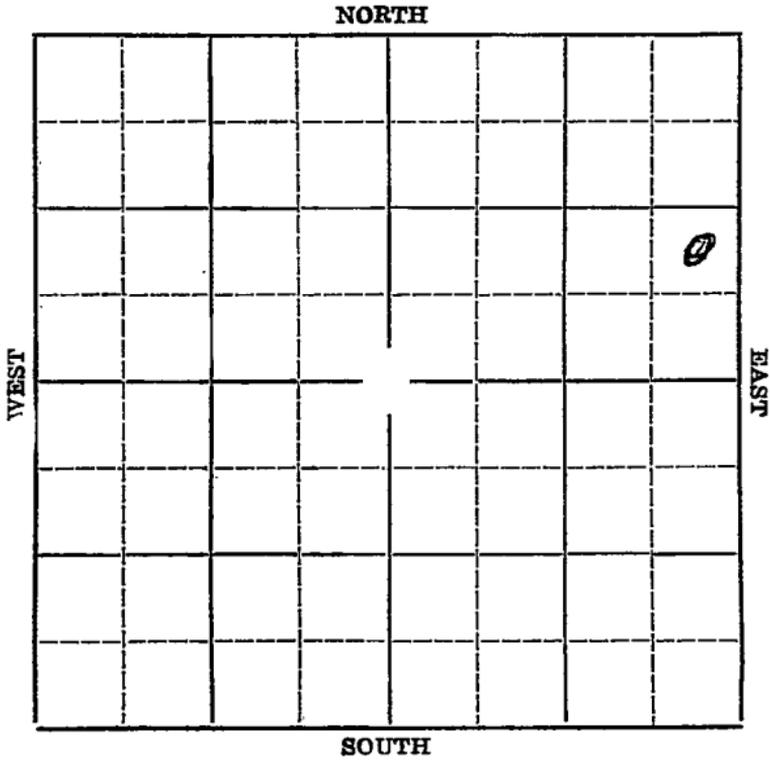

Map No. **KANSAS** Sec. **32** Twp. **19** R. **10-W**

Well No. **6-Wendel** Farm


Bradley Oil Company

_____ Ft. from N. Line

990 Ft. from S. Line

330 Ft. from E. Line

_____ Ft. from W. Line

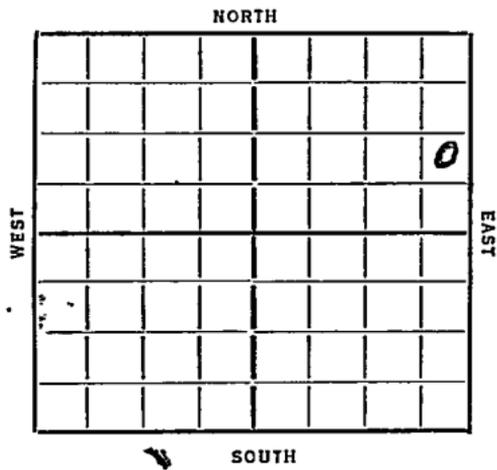

Elev. 1788

Date
1936

REPORT

4/22 Rig

4/30 1755'

5/7 Drilg. 3330'

5/13/36- No Conglomerate.

No Sil.

T.D. 3378'.

D & A

ABANDONED

Map No. 46 Sec. 32 Twp. 19 R. 10 N

Well No. 6 Hendel

Bradley Oil Company

Contractor

SECTION PLAT

			0

..... Ft. from N. Line

990 Ft. from S. Line

330 Ft. from E. Line

..... Ft. from W. Line

FIRST REPORT

Location.....

Rig up.....

Drilling and Remarks:

Rig

RECORD

Cased..... in., ft.

Sand.....

Gas.....

Oil.....

Total Depth.....

PRODUCTION

1st 24 hrs. Nat.....

1st 24 hrs. after shot.....

Gas..... Cu. Ft.

Dry Hole.....

Abandoned.....

Date

APR 22 1936

192.....

S. J. LEWIS

Scout

Map No. 46 Sec. 32 Twp. 19 R. 10 W

Well No. 6 Mendel

Bradley Oil Company

Contractor

SECTION PLAT

			0

_____ Ft. from N. Line

990 Ft. from S. Line

330 Ft. from E. Line

_____ Ft. from W. Line

ABANDONED

Location _____

Rig up _____

Drilling and Remarks:

No Conglomerate

No Oil.

J & A

RECORD

Cased _____ in., _____ ft.

Sand _____

Gas _____

Oil _____

Total Depth 3378

PRODUCTION

1st 24 hrs. Nat. _____

1st 24 hrs. after shot _____

Gas _____ Cu. Ft.

Dry Hole _____

Abandoned _____

Date

MAY 13 1936

S. J. LEWIS

Scout