


Section 32 Township 19 Range 10-W

Well Number 8 Wendell "A"

Company Republic Nat. Gas

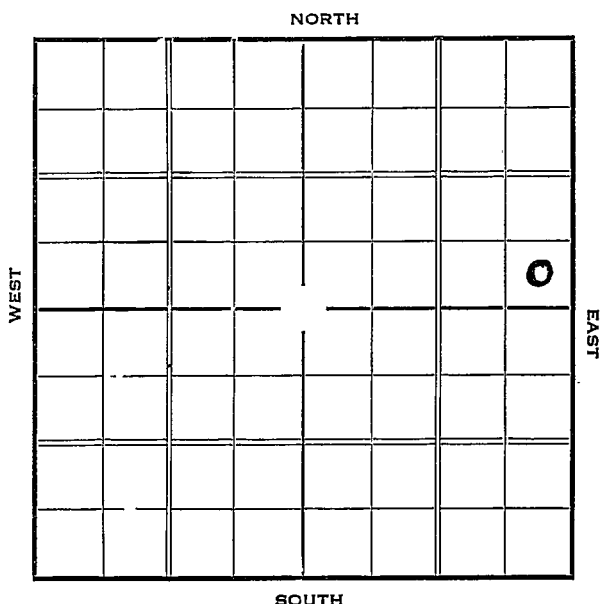

KANSAS *Rice*Map No. _____ Sec. 32 Twp. 19 R. 10WWell No. 8 WendelRepublic Nat. Gas. Company

Contractor _____

SECTION PLAT

o

_____ Ft. from N. Line

880 Ft. from S. Line930 Ft. from E. Line

_____ Ft. from W. Line

FIRST REPORT

Location _____

Rig up _____

Drilling and Remarks:

Rig

RECORD

Cased _____ in., _____ ft.

Sand _____

Gas _____

Oil _____

Total Depth _____

PRODUCTION

1st 24 hrs. Nat. _____

1st 24 hrs. after shot _____

Gas _____ Cu. Ft.

Dry Hole _____

Abandoned _____

Date

MAR 31 1937

19

C. I. LEWIS

Scout

Rice KANSAS

Map No. _____ Sec. 32 Twp. 19 R. 10 ^WWell No. J-Wendel "A"Republic Nat Gas Company

Contractor _____

CORRECTION

SECTION PLAT

_____ Ft. from N. Line

330 Ft. from S. Line330 Ft. from E. Line

_____ Ft. from W. Line

CORRECTION

			0

Location _____

Rig up _____

Drilling and Remarks:

Was #8-Wendelcorrect
farm name

RECORD

Cased _____ in., _____ ft.

Sand _____

Gas _____

Oil _____

Total Depth _____

PRODUCTION

1st 24 hrs. Nat. _____

1st 24 hrs. after shot _____

Gas _____ Cu.:Ft.

Dry Hole _____

Abandoned _____

Date

APR 28 1917

19

H. D. Hatfield Scout

Map No. 4 Sec. 32 Twp. 19 R. 10 WWell No. S-Wendel "A"Republic Oil & Gas Company

Contractor

COMPLETED**SECTION PLAT**

			0

_____ Ft. from N. Line

330 Ft. from S. Line330 Ft. from E. Line

_____ Ft. from W. Line

Location _____

Rig up _____

Drilling and Remarks:

Pot. 2140

NAT

RECORD

Cased _____ in., _____ ft.

Sand Sil 3284

Gas _____

Oil _____

Total Depth 3304**PRODUCTION**

1st 24 hrs. Nat. _____

1st 24 hrs. after shot _____

Gas _____ Cu. Ft.


Dry Hole _____

Abandoned _____

Date

MAY 5 - 1937

19

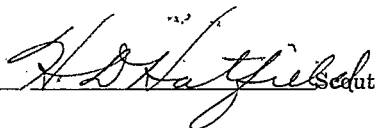
 H. D. Hatfield

Seal