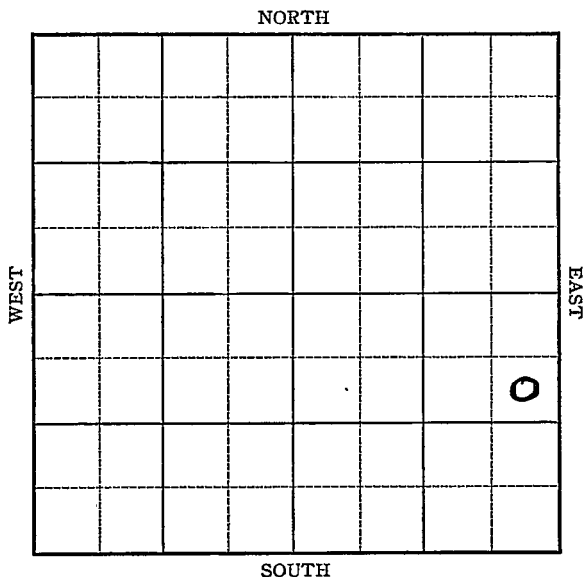
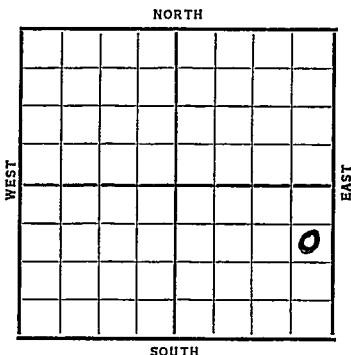


Section 32 Township 19 Range 10-WWell No. 8 Wendel "B"Company Republic

Sec. 32 Twp. 19 R. 10-WWell No. #8 Wendel "B" Farm
Republic Company990 Ft. from N. Line Ft. from S. Line330 Ft. from E. Line Ft. from W. Line

Date	REPORT
1937	
9/8	10" @ 171'. Drlg. 1986'.
9/17	Drlg. 2707'.
9/24	Sil. & 7" @ 3274'. RUST.
10/2	" " " " "
10/8	T.D. 3281'. "1000 acid"& 3000 acid.
10/13	7" @ 3274'.
	Sil. 3274'.
	T.D. 3281'.
	1000 acid.
	3000 acid.
	Pump 472.63 bbls. 4 hrs & 482.55 bbls.
	4 hrs.
	Potential 2928 bbls.
	COMPLETED

KANSAS

Map No. 46 Sec. 32 Twp. 19 R. 10WWell No. 8-Wendel 'B'Republic Company

Contractor

FIRST REPORT

SECTION PLAT

990 Ft. from N. Line

_____ Ft. from S. Line

330 Ft. from E. Line

_____ Ft. from W. Line

Location _____

Rig up _____

Drilling and Remarks:

10" 171May 1986

RECORD

Cased _____ in., _____ ft.

Sand _____

Gas _____

Oil _____

Total Depth _____

PRODUCTION

1st-24 hrs. Nat. _____

1st 24 hrs. after shot _____

Gas _____ Cu. Ft.

Dry Hole _____

Abandoned _____

Date

SEP 8 1937

H. D. Hatfield

19

Scout

Map No. _____ Sec. 32 Twp. 19 R. 10WWell No. 8 Wendel "B"_____
Republic Company_____
Contractor

COMPLETED

SE NE SE

990 Ft. from N. Line

____ Ft. from S. Line

330 Ft. from E. Line

____ Ft. from W. Line

SECTION PLAT

			0

Location _____

Rig up _____

Drilling and Remarks:

1000 Acid
3000 Acid

P- 472.6 $\frac{3}{4}$ + 482.5 $\frac{5}{4}$

POT- 2928'

RECORD

Cased 7 in., 5274 ft.Sand 511 3274

Gas _____

Oil _____

Total Depth 3281

PRODUCTION

1st 24 hrs. Nat. _____

1st 24 hrs. after shot _____

Gas _____ Cu. Ft.

Dry Hole _____

Abandoned _____

Date

OCT 13 1937 19

E. D. Hatfield

Scout