


Section 32 Township 19 Range 10-W

Well Number 4 South Wendel

Company Gulf

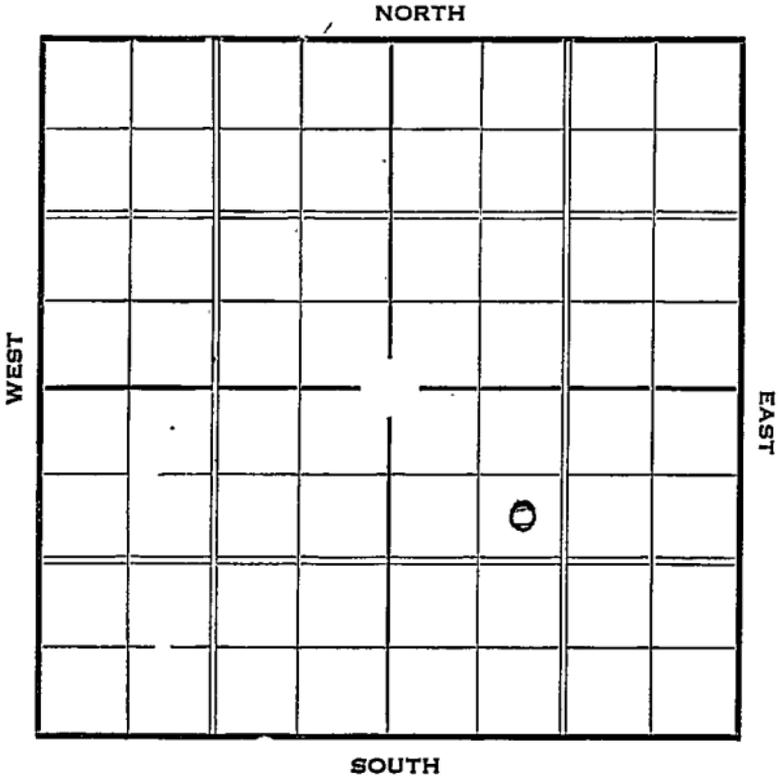

KANSAS Rice

Sec. 32 Twp. 19 R. 10 W

Well No. #4 South Wendel Farm

Gulf. Company


990 Ft. from N. Line

_____ Ft. from S. Line

_____ Ft. from E. Line

990 Ft. from W. Line

Elev. 1794

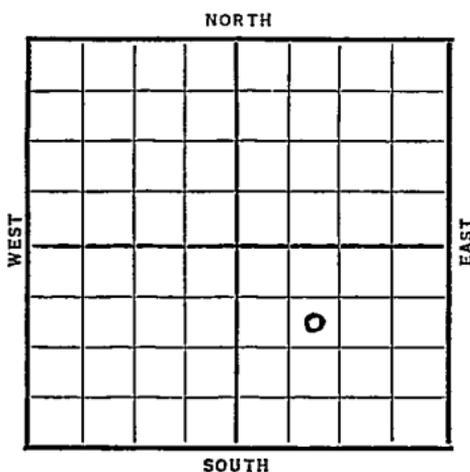

Date	REPORT
1937	
2/17	Rig
2/26	Rigging up.
3/4	10" @ 180 Drlg. 2092'.
3/11	Sil 3282'. 6" @ 3284' RUST
3/18	T.D. 3291' Testing
3/25	1000 Acid. Swabb 131 bbls.
	6 hours.
3/31	Sil. 3299'.
	T.D. 3291'.
	1000 acid.
	Potential 1186.
	COMPLETED

Map No. 46 Sec. 32 Twp. 19 R. 10W

Well No. 4 South 42 1/2 Sec 32

Gulf. Company

Contractor

SECTION PLAT

			0

990 Ft. from N. Line

_____ Ft. from S. Line

_____ Ft. from E. Line

990 Ft. from W. Line

FIRST REPORT

Location _____

Rig up _____

Drilling and Remarks:

Rig

RECORD

Cased _____ in., _____ ft.

Sand _____

Gas _____

Oil _____

Total Depth _____

PRODUCTION

1st 24 hrs. Nat. _____

1st 24 hrs. after shot _____

Gas _____ Cu. Ft.

Dry Hole _____

Abandoned _____

Date

FEB 17 1937 19

S. J. LEWIS Scout

Map No. _____ Sec. 32 Twp. 19 R. 10W

Well No. 4 S. Hendel

Gulf. Company

Contractor

SECTION PLAT

		o	

990 Ft. from N. Line

_____ Ft. from S. Line

_____ Ft. from E. Line

990 Ft. from W. Line

COMPLETED

Location _____

Rig up _____

Drilling and Remarks:

S. L. 3279
1000 acid
Potential
1186

RECORD

Cased _____ in., _____ ft.

Sand _____

Gas _____

Oil _____

Total Depth 3291

PRODUCTION

1st 24 hrs. Nat. _____

1st 24 hrs. after shot _____ *

Gas _____ Cu. Ft.

Dry Hole _____

Abandoned _____

Date

1937 19

S. J. LEWIS Scout