


Section.....32.....Township.....19.....Range.....10-W

Well Number.....5 - Wendel "B".....

Company.....Republic Nat. Gas.....

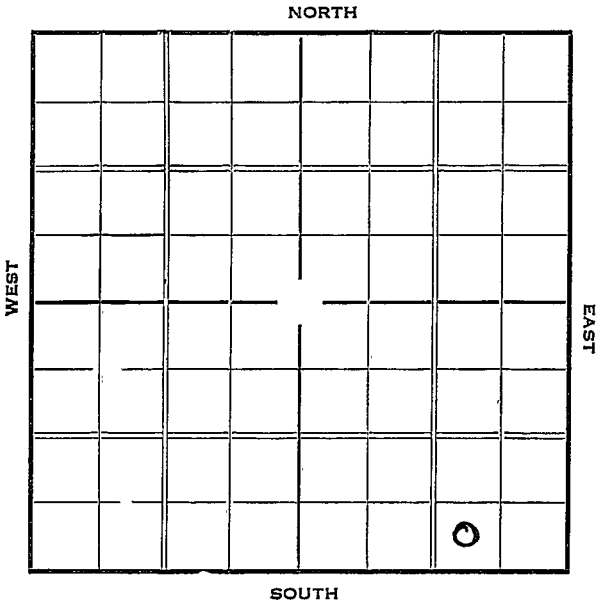

Rice KANSAS

Map No. _____ Sec. 32 Twp. 19 R. 10^wWell No. 5 - Wendel "B"Republic Nat. Gas Company

Contractor

FIRST REPORT

_____ Ft. from N. Line

330 Ft. from S. Line990 Ft. from E. Line

_____ Ft. from W. Line

SECTION PLAT

			0

Location _____

Rig up _____

Drilling and Remarks:

Rig

RECORD

Cased _____ in., _____ ft.

Sand _____

Gas _____

Oil _____

Total Depth _____

PRODUCTION

1st 24 hrs. Nat. _____

1st 24 hrs. after shot _____

Gas _____ Cu. Ft.

Dry Hole _____

Abandoned _____

Date

APR 28 1937

19

H. D. Hatfield Scout

Rice KANSAS

Map No. 46 Sec. 32 Twp. 19 R. 10 WWell No. 5-Wendel "B"Republic Company

Contractor

COMPLETED

SECTION PLAT

			0

_____ Ft. from N. Line

330 Ft. from S. Line990 Ft. from E. Line

_____ Ft. from W. Line

Location _____

Rig up _____

Drilling and Remarks:

1000 AcidPat 2141(575/6 hrs)

RECORD

Cased 7 in., 3288 ft.Sand 511 - 3288

Gas _____

Oil _____

Total Depth 3298

PRODUCTION

1st 24 hrs. Nat. _____

1st 24 hrs. after shot _____

Gas _____ Cu. Ft.

Dry Hole _____

Abandoned _____

Date

JUN 2 1937H. D. Hatfield

Scout