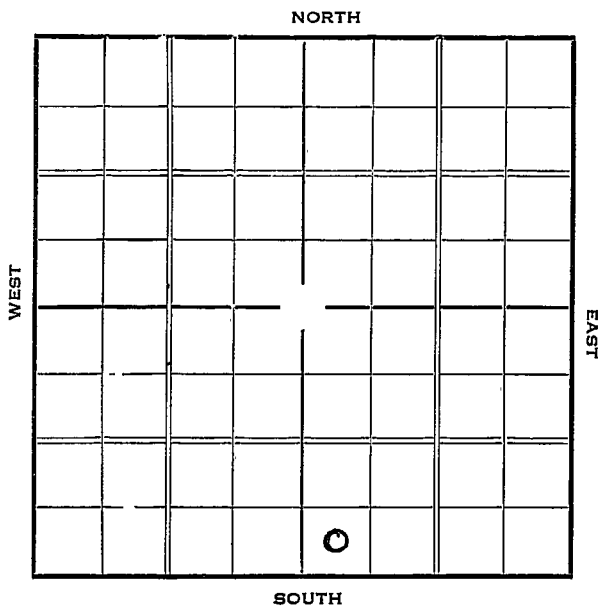


KANSAS

Rice


Section 32 Township 19 Range 10-WWell Number 6 S. WendelCompany Gulf

KANSAS

Rice

Sec. 32 Twp. 19 R. 10-WWell No. #6 S. Wendel FarmGulf Company Ft. from N. Line330 Ft. from S. Line Ft. from E. Line330 Ft. from W. Line

Elev. 1802

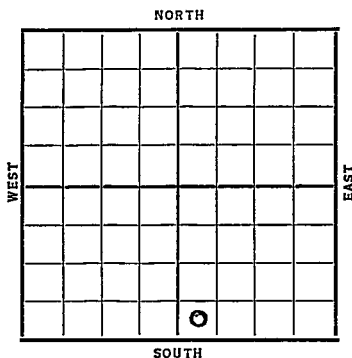

Date	REPORT
1937	
3/24	Rigging up.
4/2	10" @ 174' Drlg. 2528'.
4/8	2741' fishing
4/16	Skid rig.
4/23	10" @ 174'. Drlg. 1520'.
4/30	Drlg. 3102'.
5/7	Sil. 3280'. 6" @ 3285'.
	T.D. 3295'. Swabbed 32 oil
	6 hrs.
5/12	6" @ 3285'.
	Sil. 3280'.
	T.D. 3295'.
	2000 acid.
	Potential 1657 bbls. 24
	hours.
	COMPLETED

KANSAS *Pice*Map No. 15 Sec. 32 Twp. 19 R. 10W.Well No. 6. S. WendelGulley Company

Contractor

SECTION PLAT

		0	

_____ Ft. from N. Line

330 Ft. from S. Line

_____ Ft. from E. Line

330 Ft. from W. Line**FIRST REPORT**

Location _____

Rig up _____

Drilling and Remarks:

*Rigging up.***RECORD**

Cased _____ in., _____ ft.

Sand _____

Gas _____

Oil _____

Total Depth _____

PRODUCTION

1st 24 hrs. Nat. _____

1st 24 hrs. after shot _____

Gas _____ Cu. Ft.

Dry Hole _____

Abandoned _____

Date

MAR 24 1937

19

S. J. LEWIS Scout

Rice **KANSAS**Map No. 46 Sec. 32 Twp. 19 R. 10 ^WWell No. 6 - S. WendelGulf Company

Contractor

COMPLETED**SECTION PLAT**

_____ Ft. from N. Line

330 Ft. from S. Line

_____ Ft. from E. Line

330 Ft. from W. Line

		0	

Location _____

Rig up _____

Drilling and Remarks:

2000 acidLot - 1657/24**RECORD**Cased 6 in., 3285 ft.Sand 511 3280

Gas _____

Oil _____

Total Depth 3295**PRODUCTION**

1st 24 hrs. Nat. _____

1st 24 hrs. after shot _____

Gas _____ Cu. Ft.

Dry Hole _____

Abandoned _____

Date

MAY 12 1937 19H. D. Hatfield

Scout