


Section 32 Township 19 Range 10-W

Well Number 7 S. Wendel

Company Gulf

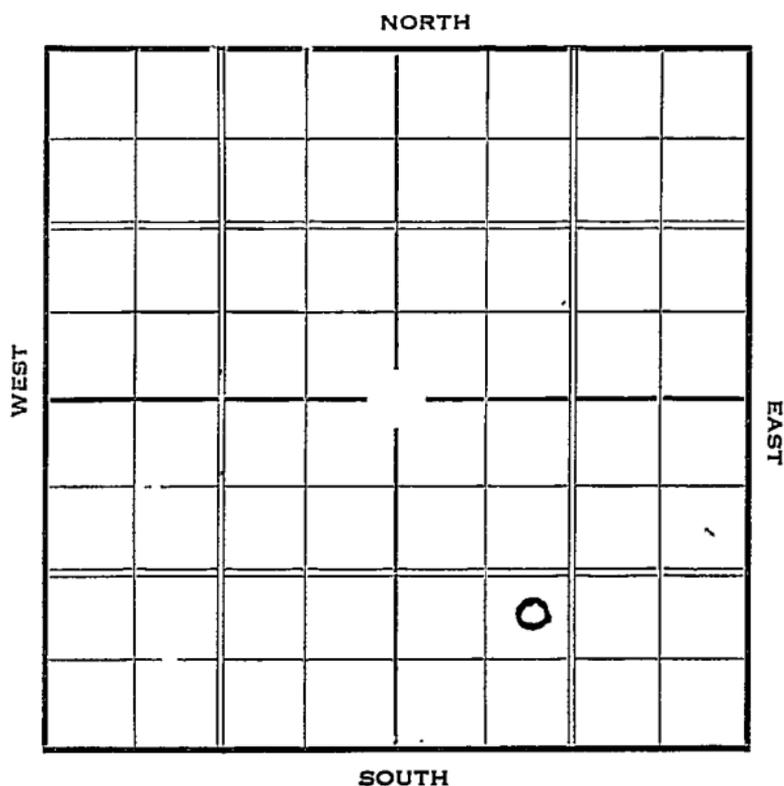

Sec. 32 Twp. 19 R. 10-W

Well No. #7 S. Wendel Farm

Gulf Company


 Ft. from N. Line

990 Ft. from S. Line

 Ft. from E. Line

990 Ft. from W. Line

Elev. 1798

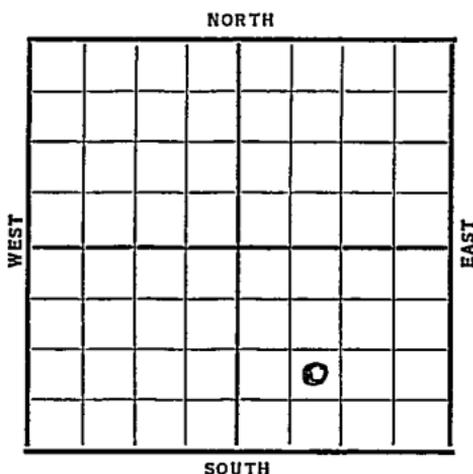

Date	REPORT
1937	
3/24	Rig
4/2	"
4/8	10" @ 188' Drlg. 2855'
4/16	Sil. 3284' set 6". T.D. 3288'. Drlg. cement.
4/28	Sil. 3284'. T.D. 3299'. 2000 acid. Pot. 1354.
	COMPLETED

Map No. 46 Sec. 32 Twp. 19 R. 10WWell No. 7 S. HendelsGaby. Company

Contractor

SECTION PLAT

_____ Ft. from N. Line

990 Ft. from S. Line

_____ Ft. from E. Line

990 Ft. from W. Line

FIRST REPORT

Location _____

Rig up _____

Drilling and Remarks:

Rig

RECORD

Cased _____ in., _____ ft.

Sand _____

Gas _____

Oil _____

Total Depth _____

PRODUCTION

1st 24 hrs. Nat. _____

1st 24 hrs. after shot _____

Gas _____ Cu. Ft.

Dry Hole _____

Abandoned _____

Date

MAR 24 1937

19

S. J. LEWIS Scout

Rice KANSAS

Map No. _____ Sec. 32 Twp. 19 R. 10^wWell No. 7 - S. WendelGulf Company

Contractor

COMPLETED**SECTION PLAT**

_____ Ft. from N. Line

990 Ft. from S. Line

_____ Ft. from E. Line

990 Ft. from W. Line

		0	

Location _____

Rig up _____

Drilling and Remarks:

2000 AcidPOT 1354**RECORD**

Cased _____ in., _____ ft.

Sand 511 - 3284

Gas _____

Oil _____

Total Depth 3299**PRODUCTION**

1st 24 hrs. Nat. _____

1st 24 hrs. after shot _____

Gas _____ Cu. Ft.

Dry Hole _____

Abandoned _____

Date

APR 28 1937

19

H. D. Hatfield Scout