


Map No. KANSAS Sec. 32 Twp. 19 R. 10 WWell No. 2 Mitchell FarmStandard Oil Company

NORTH

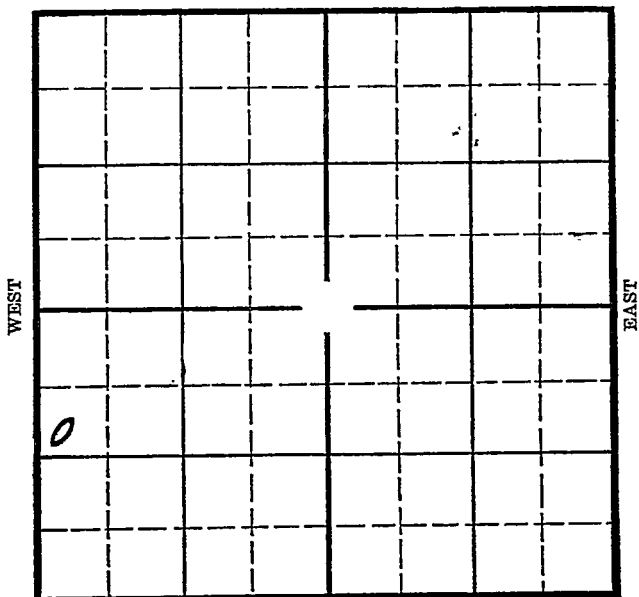

SOUTH

Location _____
Drilling Remarks _____Rig Up _____
Drilling Remarks _____

RECORD

Cased _____ in. _____ ft.

Sand _____

Gas _____

Oil _____

Total Depth _____

PRODUCTION

1st 24 hrs. Nat. _____

1st 24 hrs. after shot _____

Gas _____ cu. ft. _____

Dry Hole _____

Abandoned _____

Map No. KANSAS Sec. 32 Twp. 19 R. 10th
Well No. 2-Mitchell Farm
Stanolink Company


 Ft. from N. Line

1704 Ft. from S. Line

 Ft. from E. Line

126
90 Ft. from W. Line

TWIN

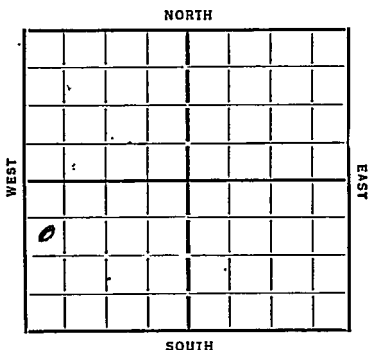

Date 1935 Elev. 1793 REPORT

10/2 Location
10/10 Rot. Rig
11/1 Sil 3284 7" 3284
 TD 3286 Rust
11/13 Sil 3284
 TD 3287
 1612 Bbls

COMPLETED

Map No. 4 Sec. 32 Twp. 19 R. 10WWell No. 2-MitchellStandard oil Company

Contractor

CORRECTION

Ft. from N. Line

1704 Ft. from S. Line

Ft. from E. Line

126 Ft. from W. Line

CORRECTION

SECTION PLAT

0			

Location

Rig up

Drilling and Remarks:

Corrected
Measurements

RECORD

Cased 7 in., ft.

Sand

Gas

Oil

Total Depth

PRODUCTION

1st 24 hrs. Nat.

1st 24 hrs. after shot

Gas Cu. Ft.

Dry Hole

Abandoned

Date

10-9-35 192ORVAL MANNSCHRECK

Scout

Returned RD
Cards 952
Tracing ✓
France Map ✓
Scarborough Map ✓
Moody Map ✓
Scarborough Plat Book ✓
Moody Plat Book ✓

KANSAS

Map No. 46 Sec. 32 Twp. 19 R. 10^WWell No. 2-MitchellStanolind Company

Contractor

FIRST REPORTS

SECTION PLAT

Ft. from N. Line

1704 Ft. from S. Line

Ft. from E. Line

90 Ft. from W. Line

(Twin well)

Location ✓

Rig up

Drilling and Remarks:

RECORD

Cased _____ in., _____ ft.

Sand _____

Gas _____

Oil _____

Total Depth _____

PRODUCTION

1st 24 hrs. Nat. _____

1st 24 hrs. after shot _____

Gas _____ Cu. Ft.

Dry Hole _____

Abandoned _____

Date

ORVAL MANNSCHRECK

10-1-35 192

Scout

We show Jones #1 Wolf
at this location. Is this a
twin well to Jones #1 Wolf

Advise

Thanks

Sam

Twin well

Returned	XXXXXX
Cards	XXXX
Tracing	GD
France Map	C
Scarborough Map	X
Moody Map	C
Scarborough Plat Book	X
Moody Plat Book	X

KANSAS

Map No. 46 Sec. 32 Twp. 19 R. 10WWell No. 2-MitchellStanolind oil Company

Contractor

SECTION PLAT

~~COVERED~~ Ft. from N. Line1704 Ft. from S. Line

Ft. from E. Line

126 Ft. from W. Lineformerly reported
as 90' W.L.

Location

Rig up

Drilling and Remarks:

1612 bbls

RECORD

Cased in. ft.

Sand Sil 3284

Gas

Oil

Total Depth 3287

PRODUCTION

1st 24 hrs. Nat.

1st 24 hrs. after shot

Gas Cu. Ft.

Dry Hole

Abandoned

Date

11-13-35 192


Scout

Returned

Cards

Tracing

France Map

Scarborough Map

Moody Map

Scarborough Flat Dock

Moody Flat Dock