


Map No. KANSAS Sec. 32 Twp. 19 R. 10 W
Well No. Wendell (Wendel) Gypsy Oil Farm _____ Company _____

Rice

NORTH

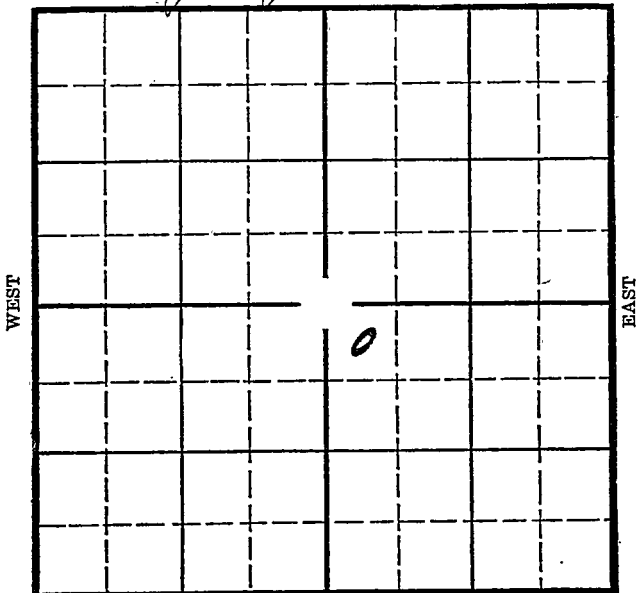

SOUTH

Location _____

Drilling Remarks _____

Rig Up _____

Drilling Remarks _____

RECORD

Cased _____ in. _____ ft.

Sand _____

Gas _____

Oil _____

Total Depth _____

PRODUCTION

1st 24 hrs. Nat. _____

1st 24 hrs. after shot _____

Gas _____ cu. ft.

Dry Hole _____

Abandoned _____

Rice
10^w

Map No. KANSAS Sec. 32 Twp. 19 R. 10^w

Well No. 1- Wendell Farm

Gypsy Oil Company


330 Ft. from N. Line

_____ Ft. from S. Line

_____ Ft. from E. Line

330 Ft. from W. Line

Elev. 1796

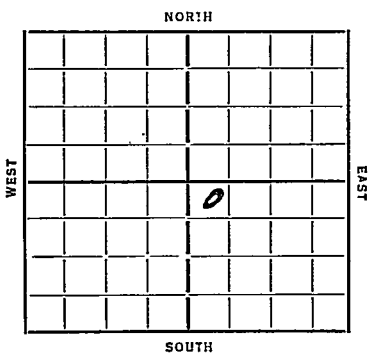

| Date | REPORT |
|------|---|
| 1935 | |
| 8/28 | Cellar |
| 9/6 | Rig |
| 10/3 | Sil 3287 T7 3305 Avg 65 bbls per hr. |
| 10/9 | Sil 3287 T7-3305 1428 bbls. |
| | |
| | |
| | |
| | |
| | |
| | |
| | |
| | |
| | |
| | |
| | |
| | |
| | |
| | |
| | |
| | |

COMPLETED

Map No. 46 Sec. 32 Twp. 19 R. 10W

Well No. 1 - Wendell

Gypsy Oil Company

Contractor

FILED RECORD

SECTION PLAT

330 Ft. from N. Line

..... Ft. from S. Line

..... Ft. from E. Line

330 Ft. from W. Line

| | | | |
|--|--|--|--|
| | | | |
| | | | |
| | | | |
| | | | |
| | | | |

Location.....

Rig up.....

Drilling and Remarks:

cellar

RECORD

Cased.....in.,ft.

Sand.....

Gas.....

Oil.....

Total Depth.....

PRODUCTION

1st 24 hrs. Nat.....

1st 24 hrs. after shot.....

Gas.....Cu. Ft.

Dry Hole.....

Abandoned.....

Date

8-28-35 192.....

ORVAL MANNSCHRECK

Scout

Map No. 46 Sec. 32 Twp. 19 R. 10^w

Well No. 1 - Wendell

Supply oil Company

Contractor

COMPLETED

SECTION PLAT

| | | | |
|--|--|---|--|
| | | | |
| | | | |
| | | 0 | |
| | | | |

330 Ft. from N. Line

..... Ft. from S. Line

..... Ft. from E. Line

330 Ft. from W. Line

Location.....

Rig up.....

Drilling and Remarks:

1428 Hrs

RECORD

Cased..... in. ft.

Sand Sil 3287

Gas.....

Oil.....

Total Depth 3305

PRODUCTION

1st 24 hrs. Nat.....

1st 24 hrs. after shot.....

Gas..... Cu. Ft.

Dry Hole.....

Abandoned.....

Date

10-9-35 192.....

ORVAL MANNSCHRECK

Scout