


Map No. KANSAS Sec. 32 Twp. 19 R. 10W
 Well No. #6 Wendel #1-SOUTH Wendel Farm
Bradley Oil. Company

NORTH

WEST

EAST

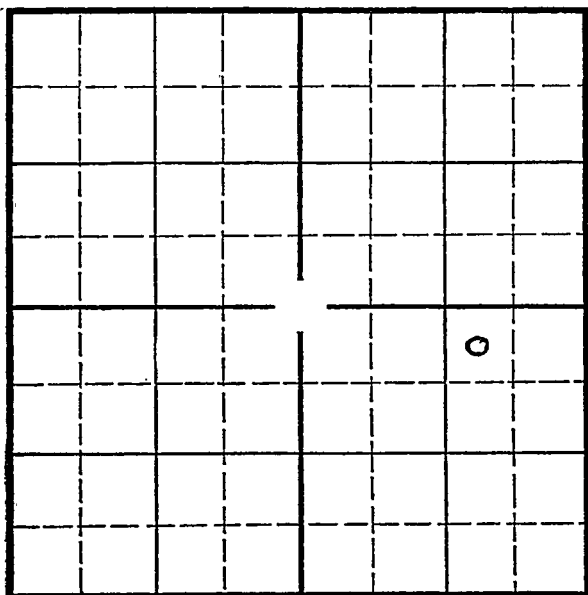

SOUTH

Location _____

Drilling Remarks _____

Rig Up _____

Drilling Remarks _____

RECORD

Cased _____ in. _____ ft.

Sand _____

Gas _____

Oil _____

Total Depth _____

PRODUCTION

1st 24 hrs. Nat. _____

1st 24 hrs. after shot _____

Gas _____ cu. ft. _____

Dry Hole _____

Abandoned _____

Map No. **KANSAS** Sec. **32** Twp. **19** R. **10-W**
Well No. ~~G-Wendel~~ **#1-SOUTH** Farm
Bradley Oil Company


330 Ft. from N. Line

Ft. from S. Line

990 Ft. from E. Line

Ft. from W. Line

Elev. 1791

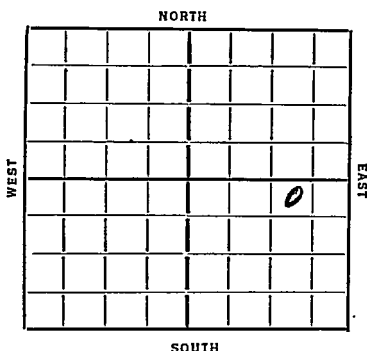

Date
1936

REPORT

4/8 Location

4/16 Rig.

4/23 Drlg. 1310'

4/30 167' Surface pipe. Drlg. 2930'.

5/7 Sil. 3297'. 7" @ 3300' RUST.

5/14 T.D. 3308'.

5/21 Shut down.

5/28 -- 6/4-- 6/11--

6/24/36-Sil. 3297'.

T.D. 3314'.

1675 bbls natural

COMPLETED

Map No. 46 Sec. 32 Twp. 19 R. 10xxWell No. 6 HendelBradley Oil Company

Contractor

SECTION PLAT

			0

330 Ft. from N. Line

Ft. from S. Line

990 Ft. from E. Line

Ft. from W. Line

FIRST REPORT

Location ✓

Rig up

Drilling and Remarks:

RECORD

Cased in., ft.Sand Gas Oil Total Depth

PRODUCTION

1st 24 hrs. Nat. 1st 24 hrs. after shot Gas Cu. Ft.Dry Hole Abandoned

Date

S. J. LEWIS

4/8/26 192

Scout

Map No. 46 Sec. 32 Twp. 19 R. 10 W

Well No. 1 South

Bradley Oil Company

Contractor

SECTION PLAT

330 Ft. from N. Line

_____ Ft. from S. Line

990 Ft. from E. Line

_____ Ft. from W. Line

			o

SECTION

Location _____

Rig up _____

Drilling and Remarks:

Report No 66 made

RECORD

Cased _____ in., _____ ft.

Sand _____

Gas _____

Oil _____

Total Depth _____

PRODUCTION

1st 24 hrs. Nat. _____

1st 24 hrs. after shot _____

Gas _____ Cu. Ft.

Dry Hole _____

Abandoned _____

Date

APR 22 1936

S. J

192

Scout

Map No. 46 Sec. 32 Twp. 19 R. 10WWell No. 1 SouthBradley Oil Company

Contractor

SECTION PLAT

			0

330 Ft. from N. Line

_____ Ft. from S. Line

990 Ft. from E. Line

_____ Ft. from W. Line

COMPLETED

Location _____

Rig up _____

Drilling and Remarks:

Oil 82971675 P.S.Nat.

RECORD

Cased _____ in., _____ ft.

Sand _____

Gas _____

Oil _____

Total Depth 3314

PRODUCTION

1st 24 hrs. Nat. _____

1st 24 hrs. after shot _____

Gas _____ Cu. Ft.

Dry Hole _____

Abandoned _____

Date

JUN 24 1936 19S. J. LEWIS Scout