


Form 51-5M-3-35-Mid-West

Map No. **KANSAS** Sec. **32** Twp. **19** R. **10W**
 Well No. **#4-Mitchell** Farm
Stanolind Company

NORTH

WEST

EAST

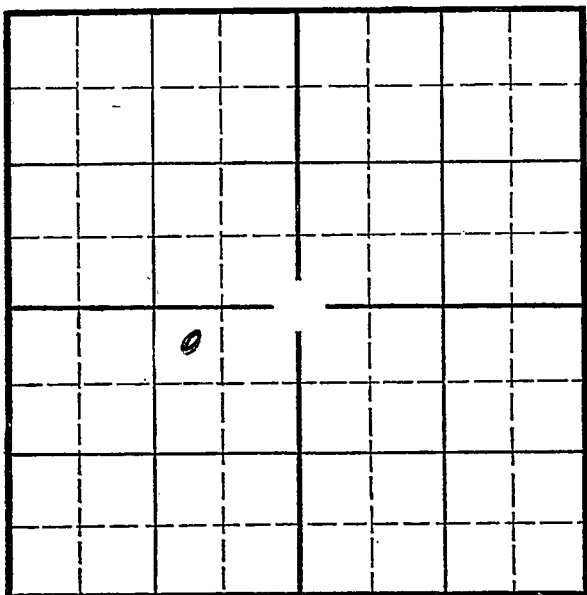

SOUTH

Location _____

Drilling Remarks _____

Rig Up _____

Drilling Remarks _____

RECORD

Cased _____ in. _____ ft.

Sand _____

Gas _____

Oil _____

Total Depth _____

PRODUCTION

1st 24 hrs. Nat. _____

1st 24 hrs. after shot _____

Gas _____ cu. ft. _____


Dry Hole _____

Abandoned _____

Map No. KANSAS Sec. 32 Twp. 19 R. 10W
Well No. 4-Mitchell Farm
Stanolink Company

330 Ft. from N. Line
990 Ft. from S. Line
990 Ft. from E. Line
Ft. from W. Line

Elev. 1800

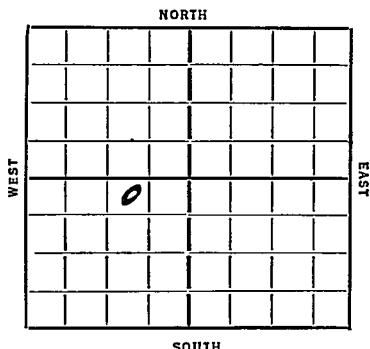

REPORT

1/1/56

2/4/9 Big Allen

2/28 Rig

3/6 Wlg 485 12" 186

3/13 2600

3/20 T. Cong. 3299 T. Sil. 3314 7"-

3315 T.D. 3321 RUST.

3/27 7"-3306 T.D. 3331 Swabbed 28 bbls
oil per hr.

4/2 Swabbed 40 bbls per hr. 3 hrs. 3000
gallons acid.

4/8 Lib 3314
T.D 3321
3000 Acid
977 Bbls.

COMPLETED

Map No. 46 Sec. 32 Twp. 19 R. 10WWell No. 4-MitchellStanolind Company

Contractor

SECTION PLAT

330 Ft. from N. Line

Ft. from S. Line

990 Ft. from E. Line

Ft. from W. Line

	0		

Location.....

Rig up.....

Drilling and Remarks:

Dig cellar

RECORD

Cased.....in.,ft.

Sand.....

Gas.....

Oil.....

Total Depth.....

PRODUCTION

1st 24 hrs. Nat.....

1st 24 hrs. after shot.....

Gas.....Cu. Ft.

Dry Hole.....

Abandoned.....

Date

2-19-36 192..... ORVAL MANNSCHRECK Scout

Map No. 46 Sec. 22 Twp. 19 R. 10W

Well No. 4 Mitchell

Stanobind Company

Contractor

SECTION PLAT

330 Ft. from N. Line

..... Ft. from S. Line

990 Ft. from E. Line

..... Ft. from W. Line

COMPLETED

	0		

Location.....

Rig up.....

Drilling and Remarks:

Sil 3314
3000 acid
977 1/2 lb.

RECORD

Cased..... in., ft.

Sand.....

Gas.....

Oil.....

Total Depth 3321

PRODUCTION

1st 24 hrs. Nat.....

1st 24 hrs. after shot.....

Gas..... Cu. Ft.

Dry Hole.....

Abandoned.....

Date

4/8/36 192

S. J. LEWIS

Scout