

Rice


Well No. **1 - Stolty** Farm

Supper Oil Company


_____ Ft. from N. Line

330 Ft. from S. Line

330 Ft. from E. Line

_____ Ft. from W. Line

Elev. 1816

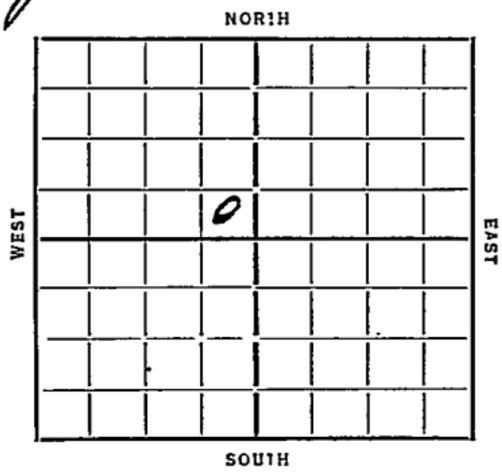

Date **1935** REPORT

7/24 Rig up.
 8/8 ddy 2200
 8/15 KOC 3045 7" 3285
 8/22 KOC 3298
 Sil 3307-15
 2000' 3 1/2 hrs
 Swab 308 12 hrs
 May deeper
 8/23 TD 3321
 Swabbing 25 Bbls per hr
 100' off ptw (Litter)
 8/23 Swab around 35 to 40
 Bbls per hour (Gel)
 8/28 Sil 3307
 TD 3325
 1134 Bbls Natural

COMPLETED

Map No. 46 Sec. 32 Twp. 19 R. 10W

Well No. 1 - Stoltz

Hygeoil Company

Contractor

COMPLETED

SECTION PLAT

	0		

Ft. from N. Line

330 Ft. from S. Line

330 Ft. from E. Line

Ft. from W. Line

Location

Rig up

Drilling and Remarks:

1134 lbs
Natural

RECORD

Cased _____ in. _____ ft.

Sand Sil 3307

Gas _____

Oil _____

Total Depth 3325

PRODUCTION

1st 24 hrs. Nat. _____

1st 24 hrs. after shot. _____

Gas _____ Cu. Ft.

Dry Hole. _____

Abandoned. _____

Date

8-28-35 192

ORVAL MANNSCHRECK

Scout

Map No. 46 Sec. 32 Twp. 19 R. 10 W

Well No. 1 Startz

Gypsum Oil Company
Contractor

FIRST REPORTS

..... Ft. from N. Line
3.30 Ft. from S. Line
3.30 Ft. from E. Line
..... Ft. from W. Line

SECTION PLAT

	0		

Location.....

Rig up

Drilling and Remarks:

RECORD

Cased..... in., ft.
Sand.....
Gas.....
Oil.....
Total Depth.....

PRODUCTION

1st 24 hrs. Nat.....
1st 24 hrs. after shot.....
Gas..... Cu. Ft.
Dry Hole.....
Abandoned.....

Date 7/24/25 192.....

~~CAVAL MANUSCRIPT~~

Scout