


Form 51-5M-3-35-Mid-West

Map No. KANSAS Sec. 32 Twp. 19 R. 10W
Well No. #3-Stoltz (Stoltz) Farm
Gulf Oil Company

NORTH

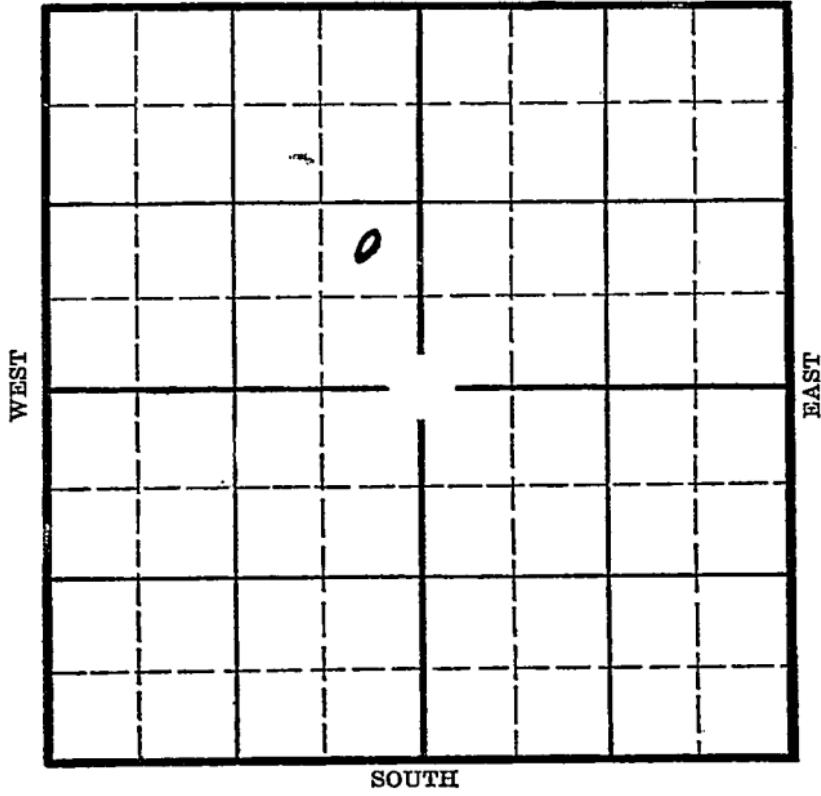

Location _____
Drilling Remarks

Rig Up _____
Drilling Remarks

RECORD


Cased _____ in. _____ ft.
Sand _____
Gas _____
Oil _____
Total Depth _____

PRODUCTION

1st 24 hrs. Nat. _____
1st 24 hrs. after shot _____
Gas _____ cu. ft. _____
Dry Hole _____
Abandoned _____

Rice

KANSAS

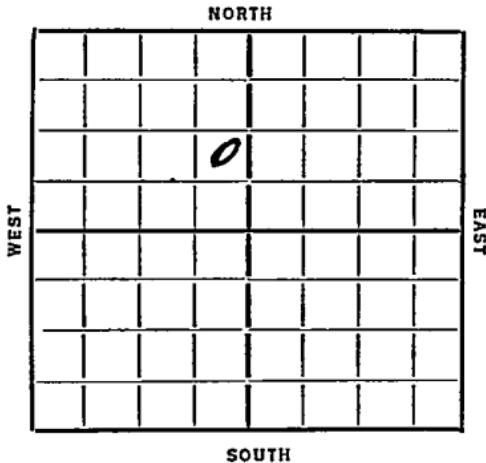Map No. _____ Sec. 32 Twp. 19 R. 10^WWell No. 3- Stoly Farm
Gulf Oil Company

Ft. from N. Line

990

Ft. from S. Line

330

Ft. from E. Line

Ft. from W. Line

Elev. 1806

REPORT

1/9/6
 2/19
 2/28
 3/6
 3/13
 3/25

LocationCorePlg 156010" 150" 3000Gil 3287TD 33001748 Bbls.COMPLETED

Map No. 46 Sec. 32 Twp. 19 R. 10^WWell No. 3-Stoly
Gulf oil Company

Contractor

FIRST

Fix 7


Ft. from N. Line

990 Ft. from S. Line

330 Ft. from E. Line

Ft. from W. Line

SECTION PLAT

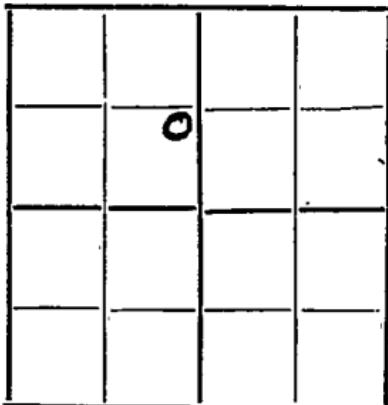Location

Rig up.....

Drilling and Remarks:

RECORD

Cased..... in., ft.

Sand.....

Gas.....

Oil.....

Total Depth.....

PRODUCTION

1st 24 hrs. Nat.....

1st 24 hrs. after shot.....

Gas..... Cu. Ft.

Dry Hole.....

Abandoned.....

Date

2-19-36 192.....

ORVAL MANNSCHRECK

Scout

KANSAS


Map No. 46 Sec. 32 Twp. 19 R. 10 W.

Well No. 3 Stoltz

Gulf Company

Contractor

SECTION PLAT

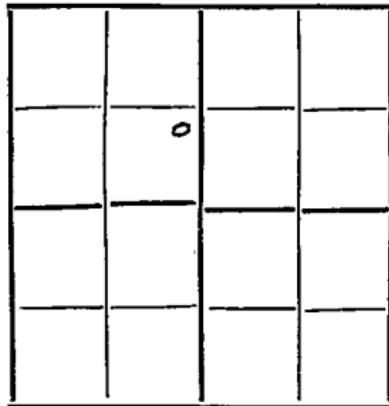

Ft. from N. Line

990 Ft. from S. Line

330 Ft. from E. Line

Ft. from W. Line

COMPLETE

Location

RECORD

Rig up

Cased in., ft.

Drilling and Remarks:

Sand

SIC 3288

Gas

Oil

Total Depth 3300

PRODUCTION

1st 24 hrs. Nat.

1st 24 hrs. after shot

Gas Cu. Ft.

Dry Hole

Abandoned

Date

3/25/36 192

S. J. LEWIS

Scout