


Map No. **KANSAS** Sec. 32 Twp. 19 R. 10 WWell No. 1 Mendel FarmH. J. Hilson et al CompanyNORTH Hitchinson

WEST

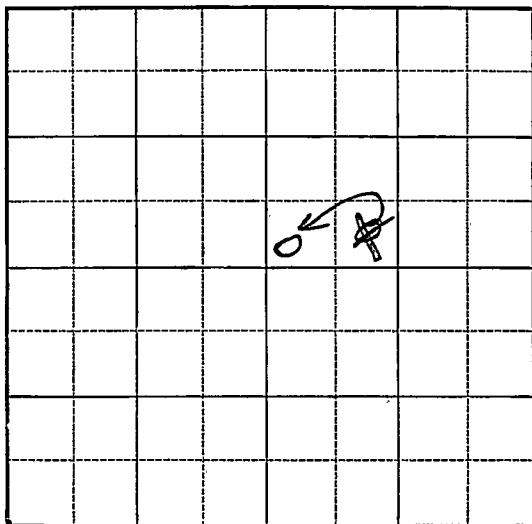

EAST

SOUTH

O. W. D. D.

Location _____

Drilling Remarks _____

Rig Up _____

Drilling Remarks _____

RECORD

Cased _____ in. _____ ft.

Sand _____

Gas _____

Oil _____

Total Depth _____

PRODUCTION

1st 24 hrs. Nat. _____

1st 24 hrs. after shot _____

Gas _____ cu. ft.

Dry Hole _____

Abandoned _____

Rice

Map No. KANSAS Sec. 32 Twp 19 R. 10^W

Well No. 1 Mendel Farm


H. J. Hilson et al Company
Hutchinson Oil Co

 Ft. from N. Line

330 Ft. from S. Line

 Ft. from E. Line

330
990 Ft. from W. Line

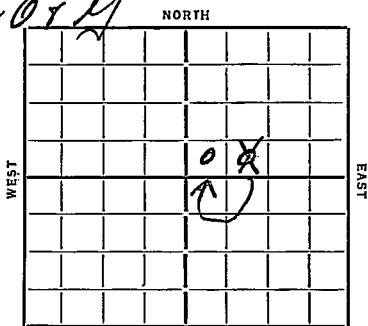

O. W. D. D.

Date

REPORT

1934	
6/13	Pond
6/21	— 6/28 — 7/5 —
7/12	— 7/19 — 7/26 —
8/2	—
8/9	Rig
8/16	— 8/23 — 8/30 — 9/6 —
9/13	— 9/20 — 9/27 — 10/4 —
10/11	— 10/18 — 10/25 — 11/1 —
11/8	— 11/15 —
11/22	Spud & SD
11/28	— 12/6 — 12/13 —
12/21	Spud
12/27	— 1/3/35 —
1/10	Spud 105 15 1/2 95
1/17	Alg 150
1/24	— 1/31 — 2/7 —
2/14	12 1/2 255 540 U.R.
2/21	12" 495 Alg 655
2/28	Alg 975
3/7	" 1150
3/14	SD 1345
3/21	Alg 1555 Sg. 1500-10.

(OVER)



3/28 SJ 1708
4/4 Dlg 1730 10" 1710
4/11 SJ 2000
4/18 — 4/26 — 5/2 — 5/9 —
5/16 Dlg 2175 8" 2165
5/23 —
5/29 SJ 2340
6/6 HFW 2670 Dlg 2694
6/13 Dlg 2758 6" 2668
6/20 6" 2700 2930 T.D.
6/28 KC 3020 50 3090
59 3094-3107
250' fluid 3117-21 UR 6"
6" 3007
7/3 Top Siliceous line 3289
Pay 3291-3293
3000 feet oil 6 hrs.
Rung 6" line
Est 1000 to 1200 Bbls (Jul)
7/11 Sil 3289 T.D. 3293
HFO 3 hrs.
7/18 —
7/25 Pumped 703 Bbls oil
22 hrs. Grad 45 (July)
7/31- Top Siliceous 3289 T.D. 3293
703 oil 21 1/2 hours
COMPLETED

O. W. D. D.

1936

5/27 Olg 3305 1/2.

6/4---

6/10/36-No increase. T.D. 3305 1/2'.

ABANDONED

REPORT

Map No. 46 Sec. 32 Twp. 19 R. 10^W

Well No. 1- Wendel

H. J. Wilson et al Company

Contractor

SECTION PLAT

		0	

Ft. from N. Line

330 Ft. from S. Line

Ft. from E. Line

330 Ft. from W. Line

Location

Rig up

Drilling and Remarks:

703 bbls

21½ hrs

RECORD

Cased _____ in., _____ ft.

Sand Shivers 3289

Gas _____

Oil _____

Total Depth 3293

PRODUCTION

1st 24 hrs. Nat. _____

1st 24 hrs. after shot _____

Gas _____ Cu. Ft.

Dry Hole _____

Abandoned _____

Date

ORVAL MANNSCHRECK

7-31-35 192

Scout

Returned _____
Cards _____
Tracing _____
Frappe Map _____
Scarborough Map _____
Moody Map _____
Scarborough Plat Book _____
Moody Plat Book _____

Map No. 46 Sec. 32 Twp. 19 R. 10 WWell No. 1 - WinkelH. J. Wilson et al Company

Contractor

CORRECTION

Ft. from N. Line

330 Ft. from S. Line

Ft. from E. Line

330 Ft. from W. Line

SECTION PLAT

		0	

CORRECTION

Location

Rig up

Drilling and Remarks:

formerly
Reported in
NE NW NE

RECORD

Cased _____ in., _____ ft.

Sand _____

Gas _____

Oil _____

Total Depth _____

PRODUCTION

1st 24 hrs. Nat. _____

1st 24 hrs. after shot _____

Gas _____ Cu. Ft.

Dry Hole _____

Abandoned _____

Date

3-6-35 192

ORVAL MANNSCHRECK

Scout

Returned *MA*
Cards *MA*
Tracing *MUS*
France Map *X*
Scarborough Map *X*
Moody Map *X*
Scarborough Plat Book
Moody Plat Book

KANSAS

Map No. 46 Sec. 32 Twp. 19 R. 10WWell No. 1-WendelH. J. Wilsom et al Company

Contractor

FIRST REPORTS

SECTION PLAT

 Ft. from N. Line330 Ft. from S. Line Ft. from E. Line990 Ft. from W. Line

Location Rig up

Drilling and Remarks:

pond

RECORD

Cased in., ft.Sand Gas Oil Total Depth

PRODUCTION

1st 24 hrs. Nat. 1st 24 hrs. after shot Gas Cu. Ft.Dry Hole Abandoned

Date

6-13-34₁₉

ORVAL MANNSCHRECK

Scout

no
see
see

Returned	<i>PH</i>
Cards	<i>PH</i>
Tracing	<i>PH</i>
France Map	<i>PH</i>
Sea. Lough Map	<i>PH</i>
Mod. Map	<i>PH</i>
Scarlough	<i>PH</i>
Moody	<i>PH</i>

Map No. 46 Sec. 32 Twp. 19 R. 10 W.

Well No. 1 Hensel

Hutchinson Oil Company

Contractor

SECTION PLAT

_____ Ft. from N. Line

330 Ft. from S. Line

_____ Ft. from E. Line

330 Ft. from W. Line

OK II

Location _____

Rig up _____

Drilling and Remarks:

OT II. 3293

Leg 3305 1/2

CORRECTION

Company Name

RECORD

Cased _____ in., _____ ft.

Sand _____

Gas _____

Oil _____

Total Depth _____

PRODUCTION

1st 24 hrs. Nat. _____

1st 24 hrs. after shot _____

Gas _____ Cu. Ft.

Dry Hole _____

Abandoned _____

Date

MAY 27 1936

19

S. J. LEWIS

Scout

[Handwritten signature]

Returned	<i>[Signature]</i>
Cards	<i>[Signature]</i>
Tracing	<i>[Signature]</i>
France Map	<i>[Signature]</i>
Sea Borough Map	<i>[Signature]</i>
Moody Map	<i>[Signature]</i>
Scarborough Flat Book	
Moody Flat Book	

Map No. 46 KANSAS Sec. 32 Twp. 19 R. 10 W

Well No. 124046

Hutchinson Oil Company

Contractor

SECTION PLAT

		0	

_____ Ft. from N. Line

330 Ft. from S. Line

_____ Ft. from E. Line

330 Ft. from W. Line

COMPLETED

Location _____

Rig up _____

Drilling and Remarks:

No Increase

RECORD

Cased _____ in., _____ ft.

Sand _____

Gas _____

Oil _____

Total Depth: 330 5 1/2

PRODUCTION

1st 24 hrs. Nat. _____

1st 24 hrs. after shot _____

Gas _____

Dry Hole _____

Abandoned _____

Date

JUN 10 1936

19

J. LEWIS

Scout

[Handwritten signature]
[Handwritten signature]

Returned	<i>[Signature]</i>
Cards	<i>[Signature]</i>
Tracing	<i>[Signature]</i>
France Map	<i>[Signature]</i>
Scarborough Map	<i>[Signature]</i>
Moody Map	<i>[Signature]</i>
Scarborough Plat Book	
Moody Plat Book	