


Map No. KANSAS Sec. 32 Twp. 19 R. 10

Well No. 23 Wendell Farm  
Grass Oil Company

**NORTH**

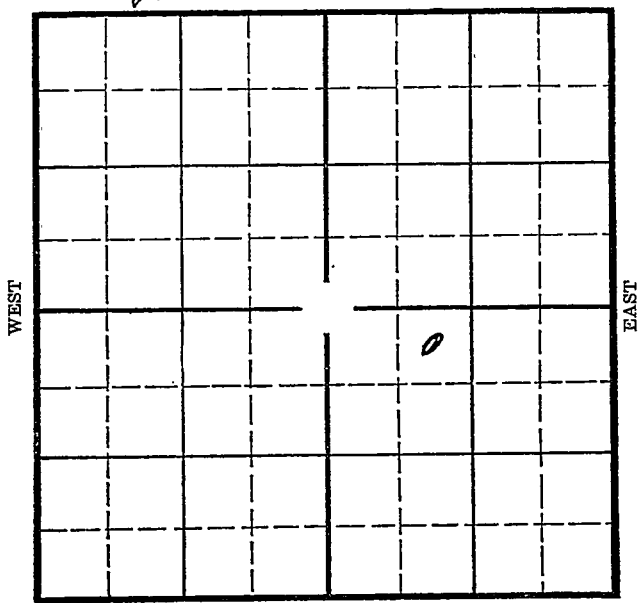

**SOUTH**

Drilling Remarks

Drilling Remarks

Cased \_\_\_\_\_ in. \_\_\_\_\_ ft.

Sand\_\_\_\_\_

Gas\_\_\_\_\_

## Oil

Total Depth\_\_\_\_\_

1st 24 hrs. Nat. \_\_\_\_\_

1st 24 hrs. after shot\_\_\_\_\_

Gas\_\_\_\_\_cu. ft.\_\_\_\_\_

Dry Hole\_\_\_\_\_

Abandoned\_\_\_\_\_

Map No. KANSAS Sec. 32 Twp. 19 R. 10<sup>W</sup>  
Well No. 2-Wendel Farm  
Murray Oil Company


330 Ft. from N. Line

\_\_\_\_\_ Ft. from S. Line

\_\_\_\_\_ Ft. from E. Line

990 Ft. from W. Line

Elev. 1796

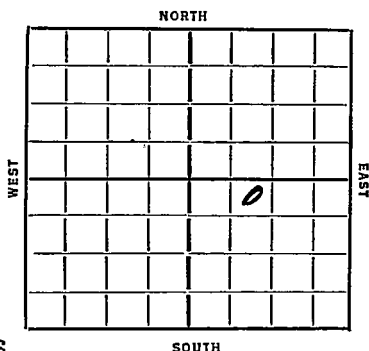

REPORT

~~1/29~~ Bldg R. Rig  
2/7 dly 450  
2/14 " 2290  
2/21 Coring 3284  
2/28 Sil 3300 1/2 7" 3301 TD 3313  
filled 1800' 8 hrs  
Swabbed 65 Bbls 6 hrs off Btm  
3/6 TD 3320 2300' Oil  
Shot 15 gts 3305-20  
Damaged pipe 2090-98  
3/13 Recieve pipe  
3/20 T.D. 3320 Running 5"  
3/27 5" 3298 Drlg. Plug.  
4/2 T.D. 3320' Pumped 240 bbls nat.  
4/8 Sil 3300 1/2 TD 3320  
Shot 20 gts 3305-20  
1000 acq  
Potential 1584.

COMPLETED

Map No. 46 Sec. 32 Twp. 19 R. 10WWell No. 2-WendelExxon oil Company

Contractor

## FIRST REPORTS

330 Ft. from N. Line

Ft. from S. Line

Ft. from E. Line

990 Ft. from W. Line

## SECTION PLAT

|  |  |   |  |
|--|--|---|--|
|  |  |   |  |
|  |  |   |  |
|  |  | 0 |  |
|  |  |   |  |

Location

Rig up

Drilling and Remarks:

Beag & Rig

## RECORD

Cased in, ft.

Sand

Gas

Oil

Total Depth

## PRODUCTION

1st 24 hrs. Nat.

1st 24 hrs. after shot

Gas Cu. Ft.

Dry Hole

Abandoned

Date

1-29-36 192ORVAL MANNSCHRECK  
Scout

Map No. 46 Sec 32 Twp. 19 R. 10 W.

Well No. 2 S Wendel

Gay Company

Contractor

SECTION PLAT

330 Ft. from N. Line

..... Ft. from S. Line

..... Ft. from E. Line

990 Ft. from W. Line

|  |  |   |  |
|--|--|---|--|
|  |  |   |  |
|  |  |   |  |
|  |  | 0 |  |
|  |  |   |  |
|  |  |   |  |

COMPLETED

Location.....

Rig up.....

Drilling and Remarks:

*Sil 33 00 1/2.*  
*Shot 209 to 3305-20*  
*1000 acid*  
*Potential*  
*1584*

RECORD

Cased..... in., ..... ft.

Sand.....

Gas.....

Oil.....

Total Depth 3320

PRODUCTION

1st 24 hrs. Nat.....

1st 24 hrs. after shot.....

Gas..... Cu. Ft.

Dry Hole.....

Abandoned.....

Date

4/8/36 192..... S. J. LEWIS Scout