


Map No. KANSAS Sec. 32 Twp. 19 R. 10<sup>w</sup>

Well No. 2 - Weyntel Farm \_\_\_\_\_  
Hutchinson Oil Company \_\_\_\_\_

*Rice*

NORTH

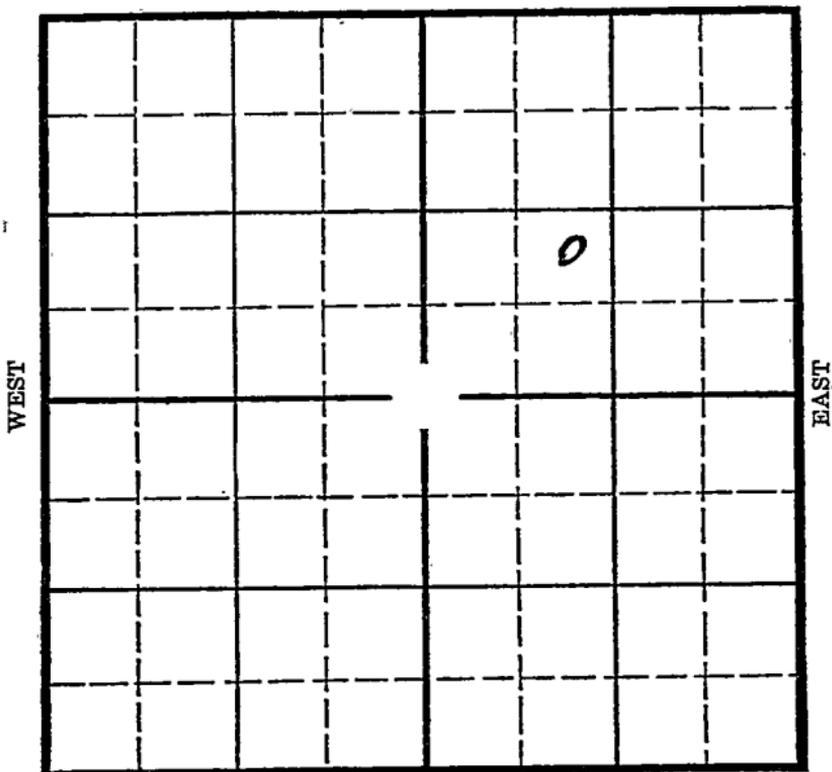

SOUTH

Location \_\_\_\_\_

Drilling Remarks \_\_\_\_\_

Rig Up \_\_\_\_\_

Drilling Remarks \_\_\_\_\_

\_\_\_\_\_

\_\_\_\_\_

RECORD

Cased \_\_\_\_\_ in. \_\_\_\_\_ ft.

Sand \_\_\_\_\_

Gas \_\_\_\_\_

Oil \_\_\_\_\_

Total Depth \_\_\_\_\_

PRODUCTION

1st 24 hrs. Nat. \_\_\_\_\_

1st 24 hrs. after shot \_\_\_\_\_

Gas \_\_\_\_\_ cu. ft. \_\_\_\_\_

Dry Hole \_\_\_\_\_

Abandoned \_\_\_\_\_

Rice  
10<sup>W</sup>

Map No. KANSAS Sec. 32 Twp. 19 R. 10<sup>W</sup>

Well No. 2- Wendel Farm  
Hutchinson Oil Company

Ft. from N. Line

990


Ft. from S. Line

Ft. from E. Line

990

Ft. from W. Line

Elev. 1800

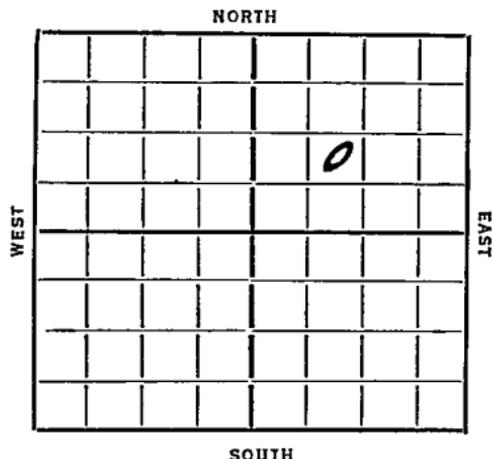

REPORT

1936  
1/15 B.K. & M.D. Cable Tools  
1/24 Spud  
1/31 500 20" 93  
2/7 " 1380 12" 985  
2/14 " 2125 8" 2156  
2/21 " 2625 6" 2605  
2/28 " 2995 40 2940  
3/6 T. Oil 3300 TD 3309  
Ship Oil Pump 5"  
3/13 Pay 3325-3329 TD 3330  
Acidizing  
3/25 Oil 3330  
TD 3330  
Pay 3325-29  
10,000 acid  
1485 lbs.

COMPLETED

Map No. 46 Sec. 32 Twp. 19 R. 10W

Well No. 2 - Wendel

Hatchinson Oil Company

Contractor

**FIRST REPORTS**

..... Ft. from N. Line

990 Ft. from S. Line

..... Ft. from E. Line

990 Ft. from W. Line

**SECTION PLAT**

		o	

Location.....

Rig up.....

Drilling and Remarks;

*B.R. + moving  
in cable tools*

**RECORD**

Cased..... in., ..... ft.

Sand.....

Gas.....

Oil.....

Total Depth.....

**PRODUCTION**

1st 24 hrs. Nat.....

1st 24 hrs. after shot.....

Gas..... Cu. Ft.

Dry Hole.....

Abandoned.....

Date

1-15-36 192.....

**ORVAL MANNSCHRECK**

Scout

Map No. 46 Sec. 32 Twp. 19 R. 10 N

Well No. 2 Hendel

Hutchinson Oil Company

Contractor


SECTION PLAT

..... Ft. from N. Line

990 Ft. from S. Line

..... Ft. from E. Line

990 Ft. from W. Line

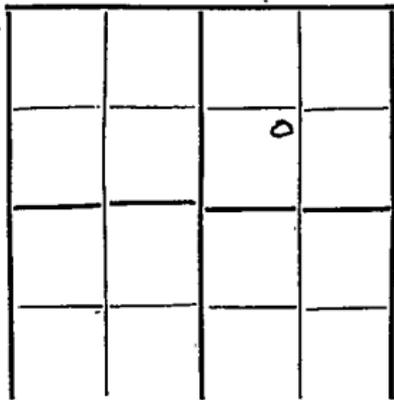

COMPLETE

Location.....

Rig up.....

Drilling and Remarks:

*Top Oil 3300*  
*Pay. 3325-29*  
*10,000 acid*  
*1485 8/16*

RECORD

Cased..... in., ..... ft.

Sand.....

Gas.....

Oil.....

Total Depth... 3330.....

PRODUCTION

1st 24 hrs. Nat.....

1st 24 hrs. after shot.....

Gas..... Cu. Ft.

Dry Hole.....

Abandoned.....

Date

3/25/26 192.....

S. J. LEWIS

Scout