

Map No.

KANSAS

Sec.

32

Twp.

19

R.

Rice
10^W


Well No.

2- Weydel
Bradley Oil

Farm

Company

NORTH

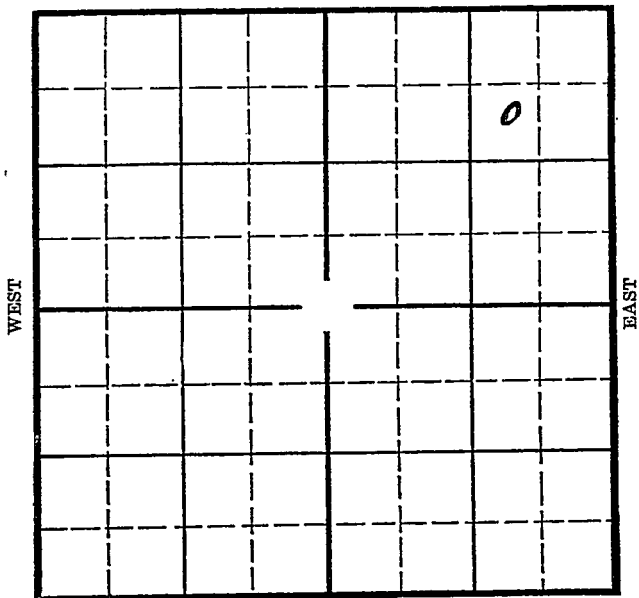

SOUTH

Location

Drilling Remarks

Rig Up

Drilling Remarks

RECORD

Cased _____ in. _____ ft.

Sand _____

Gas _____

Oil _____

Total Depth _____

PRODUCTION

1st 24 hrs. Nat. _____

1st 24 hrs. after shot _____

Gas _____ cu. ft. _____

Dry Hole _____

Abandoned _____

Map No. KANSAS Sec. 32 Twp. 19 R. 10^w
Well No. 2- Wendel Farm
Bradley Oil Company


990 Ft. from N. Line

 Ft. from S. Line

990 Ft. from E. Line

 Ft. from W. Line

Elev. 1789

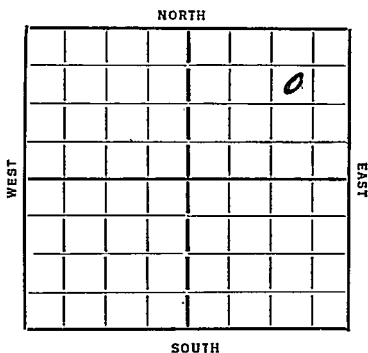

REPORT

1936
1/15 B. Rot Rig
1/24 Log 1195 10" 195
1/31 " 2665
2/7 9" 3281 T Sil 3281 Rust
2/12 Sil 3272
TD 3294
1142 Blk Natural

COMPLETED

KANSAS

Map No. 46 Sec. 32 Twp. 19 R. 10W

Well No. 2 - Wendel

Bradley Oil Company

Contractor

FIRST REPORTS

SECTION PLAT

990 Ft. from N. Line

..... Ft. from S. Line

990 Ft. from E. Line

..... Ft. from W. Line

			0

Location.....

Rig up.....

Drilling and Remarks:

B. Rot. Rig

RECORD

Cased.....in., ...ft.

Sand.....

Gas.....

Oil.....

Total Depth.....

PRODUCTION

1st 24 hrs. Nat.....

1st 24 hrs. after shot.....

Gas.....Cu. Ft.

Dry Hole.....

Abandoned.....

Date

ORVAL MANNSCHRECK

1-15-36 192.....Scout

Map No. 46 Sec. 32 Twp. 19 R. 10WWell No. 2-WendelBradley Oil Company

Contractor

COMMITTEE

SECTION PLAT

990 Ft. from N. Line

Ft. from S. Line

990 Ft. from E. Line

Ft. from W. Line

			0

Location

Rig up

Drilling and Remarks:

1142 bbls
Natural

RECORD

Cased _____ in. _____ ft.

Sand Sil 3272

Gas _____

Oil _____

Total Depth 3294

PRODUCTION

1st 24 hrs. Nat. _____

1st 24 hrs. after shot _____

Gas _____ Cu. Ft.

Dry Hole _____

Abandoned _____

Date

2-12-36 192 Orval m ScoutJPB