



NORTH

WEST

EAST

SOUTH

0

Location _____
Drilling Remarks _____

Rig Up_____

Drilling Remarks

RECORD

Cased _____ in. _____ ft.

Sand.....

Gas.....

Oil_____

Total Depth_____

PRODUCTION

1st 24 hrs. Nat.-----

1st 24 hrs. after shot_____

Gas_____cu. ft._____

Dry Hole_____

Abandoned_____

KANSAS

Map No. _____ Sec. 32 Twp. 19 R. 10^W

Well No. 1-Wolf Farm _____

E. F. Jones Company _____

NORTH

_____ Ft. from N. Line

1470 Ft. from S. Line

_____ Ft. from E. Line

130 Ft. from W. Line

WEST

EAST

SOUTH

Date 7/3/5

REPORT

7/10 Ponds
7/18 _____
8/8 Rgn
8/15 dly 1510
8/22 " 2830 N @ 3030
8/23 " 3190
8/26 Top siliceous line 3280 (21)
T-7 3280
Setting 7" 3277
Nice show oil
Well running good (21)
8/31 dly in tomorrow (21)
9/3 dly cement (21)
9/4 Drilled plugs
Made 1 foot of new hole
T-7 ~~3287~~ 3283
Filled up 500 feet oil in 1 hr
& 40 minutes
Now CO on Btm (21)

(OVER)

9/4 Corrected T 3283
500 fut oil 1 hr & 40 Min
drilled 2 fut deeper
T 3285
filled up 2000 feet more
in 1 1/2 hrs while dly.
2 fut
don't know if they will
deepen (Tel)

9/5 Correction
T Silicious 3280
T 3289
Last 2 fut big increase
Filled up 2500 fut oil
in 2 hrs in a 8 1/4" pipe
Bldg tanks
Have 1-500 bbl tank
Built (Tel)

9/10 Started taking potential
this morning (Tel)

9/11 Will start taking potential
today (Tel)

Map No. _____ Sec. _____ Twp. _____ R. _____

Well No. _____ Farm _____


_____ Company _____

_____ Ft. from N. Line

_____ Ft. from S. Line

_____ Ft. from E. Line

_____ Ft. from W. Line

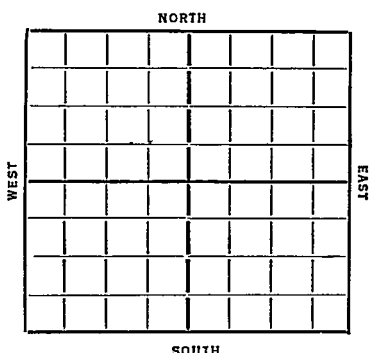

Date

REPORT

9/12 Taking potential
1st 16 hrs averaged 50 Bbls
per hr. Have poor equipment
on this well With better
equipment will make
around 70 Bbls per hr (24)
9/13 Make 1240 Bbls 22 1/2 hrs.
Poor pumping equipment
Pumping 28 strokes a Minute
With good equipment looks
like around 2000 Bbl well (24)
9/20 Sil 3280
TD 3289
1240 Bbls 22 hrs.

COMPLETED

Map No. 46 Sec. 32 Twp. 19 R. 10W

Well No. 1- Wolf

E. F. Jones & Rose Spring Company

KANSAS

Contractor

COMPLETED

SECTION PLAT

Ft. from N. Line

1470 Ft. from S. Line

Ft. from E. Line

130 Ft. from W. Line

Location

Rig up

Drilling and Remarks:

1240 lbs

22 hrs

RECORD

Cased in., ft.

Sand 3280

Gas

Oil

Total Depth 3289

PRODUCTION

1st 24 hrs. Nat.

1st 24 hrs. after shot

Gas Cu. Ft.

Dry Hole

Abandoned

Date

ORVAL MANNSCHRECK

9-20-35 192

Scout

Returned

Cards

Tracing

France Map

Scarborough Map

Moody Map

Scarborough Plat Book

Moody Plat Book

Map No. 46 Sec. 32 Twp. 19 R. 10WWell No. 1-WolfE. F. Jones Company

Contractor

FIRST REPORTS

SECTION PLAT

Ft. from N. Line

1470 Ft. from S. Line

Ft. from E. Line

130 Ft. from W. Line

0	=	-	-

SPECIAL

Location

Rig up

Drilling and Remarks:

RECORD

d in., ft.

Gas

Oil

Total Depth

PRODUCTION

1st 24 hrs. Nat.

1st 24 hrs. after shot

Gas Cu. Ft.

Dry Hole

Abandoned

Date

7-10-35 192 Scout








Moody