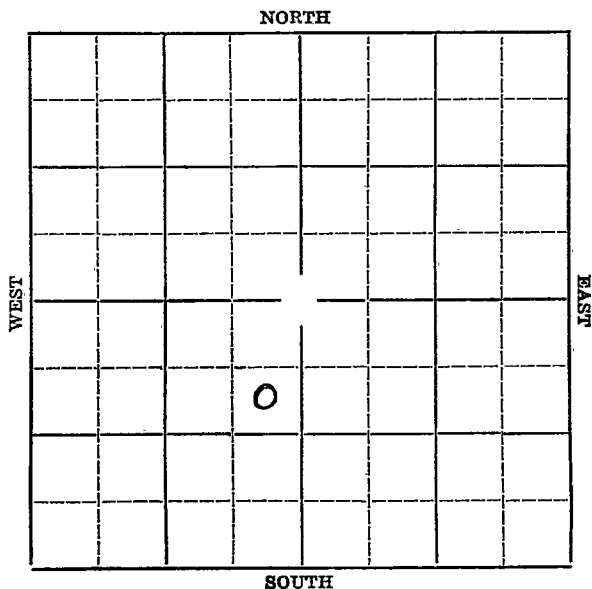



KANSAS

Rice

Section 32 Township 19 Range 10-WWell Number 8 MitchellCompany Stanolind

KANSAS RiceSec. 32 Twp. 19 R. 10-WWell No. #8 Mitchell FarmStanolind Company970 Ft. from N. Line Ft. from S. Line330 Ft. from E. Line Ft. from W. Line

Elev. 1800

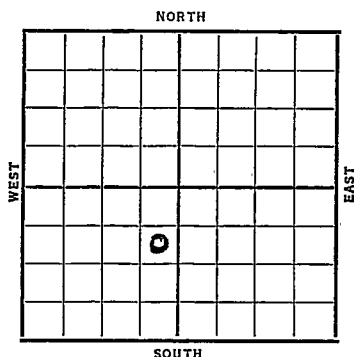~~1937~~

REPORT

3/17 Location

3/25 Drlg. 180'.

4/2 Drlg. 1600'.

4/8 Drlg. 2931'

4/16 Sil. 3303'. 6" @ 3298'.

T.D. 3305'. RUST.

4/23 Drlg. 3306'. 1200' oil in
hole $1\frac{1}{2}$ hours.

4/28 Sil. 3298'.

T.D. 3313'.

Pot. 1872.

COMPLETED

KANSAS *Rice*Map No. 46 Sec. 32 Twp. 19 R. 10WWell No. 8 MitchellStan & Lind Company

Contractor

SECTION PLAT

970 Ft. from N. Line

_____ Ft. from S. Line

330 Ft. from E. Line

_____ Ft. from W. Line

FIRST REPORTLocation ✓

Rig up _____

Drilling and Remarks:

RECORD

Cased _____ in., _____ ft.

Sand _____

Gas _____

Oil _____

Total Depth _____

PRODUCTION

1st 24 hrs. Nat. _____

1st 24 hrs. after shot _____

Gas _____ Cu. Ft.

Dry Hole _____

Abandoned _____

Date

MAR 17 1937

19

S. J. LEWIS

Scout

Rice KANSAS

Map No. _____ Sec. 32 Twp. 19 R. 10 ^WWell No. 8-MitchellStanolind Company

Contractor _____

COMPLETED970 Ft. from N. Line

_____ Ft. from S. Line

330 Ft. from E. Line

_____ Ft. from W. Line

SECTION PLAT

Location _____

Rig up _____

Drilling and Remarks:

POT 1872**RECORD**

Cased _____ in., _____ ft.

Sand 511-3298

Gas _____

Oil _____

Total Depth 3313**PRODUCTION**

1st 24 hrs. Nat. _____

1st 24 hrs. after shot _____

Gas _____ Cu. Ft.

Dry Hole _____

Abandoned _____

Date

Aug 8 1937

19

H. D. Hatfield Scout