


Map No. **KANSAS** Sec. **32** Twp. **19** R. **10 W**
 Well No. **3-Wendy** Farm
Bradley Oil Company

NORTH

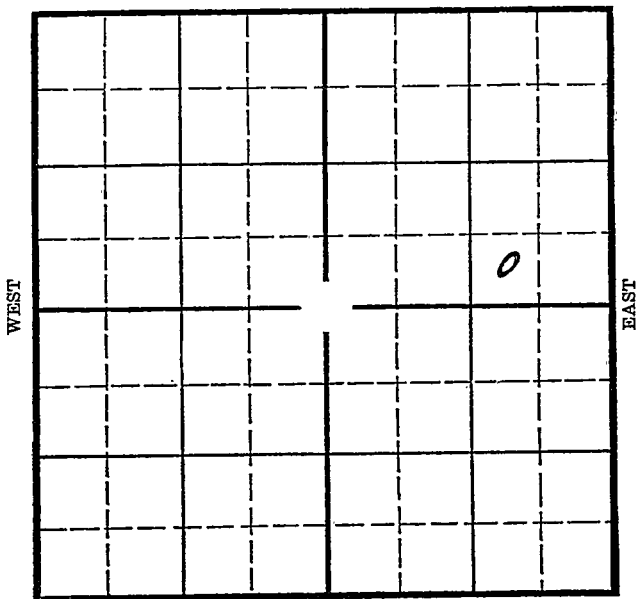

SOUTH

Location

Drilling Remarks

Rig Up

Drilling Remarks

RECORD

Cased in. ft.

Sand

Gas

Oil

Total Depth

PRODUCTION

1st 24 hrs. Nat.

1st 24 hrs. after shot

Gas cu. ft.

Dry Hole

Abandoned

Map No. KANSAS Sec. 32 Twp. 19 R. 10W
Well No. 3- Wendel Farm
Bradley Oil Company


 Ft. from N. Line

330 Ft. from S. Line

990 Ft. from E. Line

 Ft. from W. Line

Elev. 1791

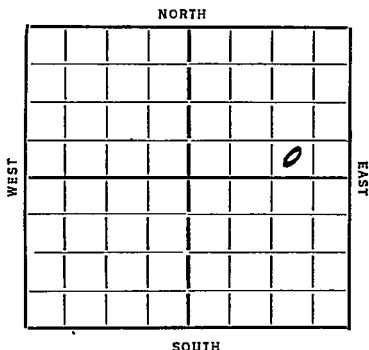

REPORT

1936
1/15 Location
1/24 Celler
1/31
2/7 Ru
2/14 Sly 300
2/21 id 2690
2/28 Sil 3289 6" 3289
TD 3291 Rust
3/6 Pay 3289-3310 TD 3313
HFO 8 hrs Pump Tubg
3/11 Sil 3289
TD 3313
1308 Natural

COMPLETED

KANSAS

Map No. 46 Sec. 32 Twp. 19 R. 10W

Well No. 3 - Wendel

Bradley Oil Company

Contractor

FIRST REPORTS

SECTION PLAT

.....Ft. from N. Line

330 Ft. from S. Line

990 Ft. from E. Line

.....Ft. from W. Line

			o

Location.....

Rig up.....

Drilling and Remarks:

RECORD

Cased.....in.,ft.

Sand.....

Gas.....

Oil.....

Total Depth.....

PRODUCTION

1st 24 hrs. Nat.....

1st 24 hrs. after shot.....

Gas.....Cu. Ft.

Dry Hole.....

Abandoned.....

Date

ORVAL MANNSCHRECK

1-15-36 192.....Scout

Map No. 46 Sec. 32 Twp. 19 R. 10 WWell No. 3- WendelBradley oil Company

Contractor

COMPLETE

Ft. from N. Line

330 Ft. from S. Line990 Ft. from E. Line

Ft. from W. Line

SECTION PLAT

			0

Location

Rig up

Drilling and Remarks:

1308 natural

RECORD

Cased in. ft.

Sand Sil 3289

Gas

Oil

Total Depth 3313

PRODUCTION

1st 24 hrs. Nat.

1st 24 hrs. after shot

Gas Cu. Ft.

Dry Hole

Abandoned

Date

ORVAL MANNSCHRECK

3-11-36 192

Scout