


Section 32 Township 19 Range 10-W

Well Number 2 S. Wendel-"B"

Company Republic Nat. Gas.

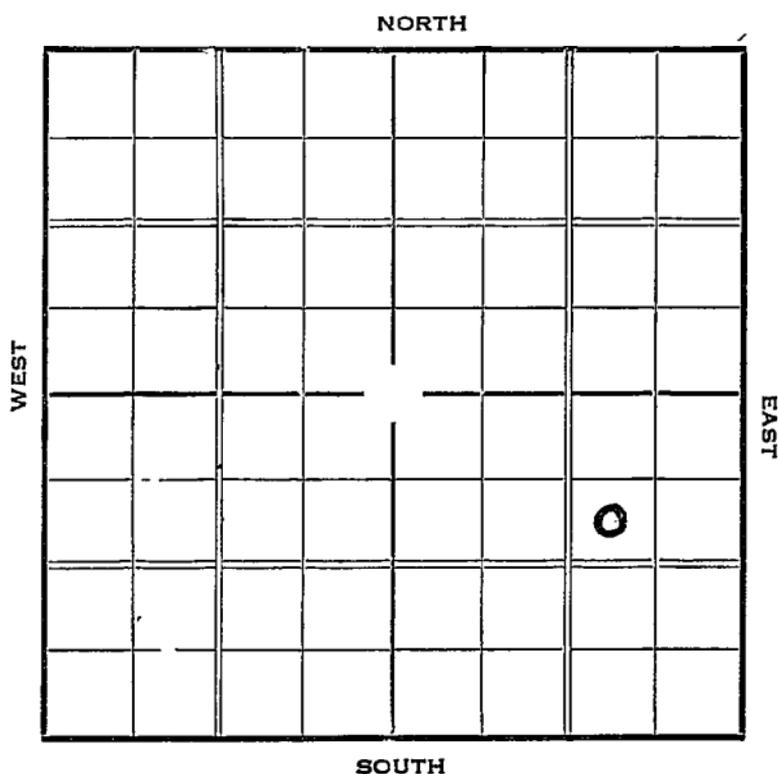

KANSAS *Pice*Map No. _____ Sec. 32 Twp. 19 R. 10WWell No. 2 S. HendelRepublic Nat. Gas Company

Contractor

SECTION PLAT

990 Ft. from N. Line

_____ Ft. from S. Line

990 Ft. from E. Line

_____ Ft. from W. Line

			0
			.

FIRST REPORT

Location _____

Rig up _____

Drilling and Remarks:

Rigging up

RECORD

Cased _____ in., _____ ft.

Sand _____

Gas _____

Oil _____

Total Depth _____

PRODUCTION

1st 24 hrs. Nat. _____

1st 24 hrs. after shot _____

Gas _____ Cu. Ft.

Dry Hole _____

Abandoned _____

Date

MAR 31 1937 19

C. J. LEWIS

Scout

Rice KANSAS

Map No. 46 Sec. 32 Twp. 19 R. 10^w

Well No. 2 - S. Wendel "B"

Republic Natural Gas Company

Contractor

COMPLETED

990 Ft. from N. Line

_____ Ft. from S. Line

990 Ft. from E. Line

_____ Ft. from W. Line

SECTION PLAT

			0

Location _____

Rig up _____

Drilling and Remarks:

POT 2245
nat.

RECORD

Cased _____ in., _____ ft.

Sand Sil - 3278

Gas _____

Oil _____

Total Depth 3295

PRODUCTION

1st 24 hrs. Nat. _____

1st 24 hrs. after shot _____

Gas _____ Cu. Ft.

Dry Hole: _____

Abandoned _____

Date

APR 28 1937

19

W. D. Hatfield Scout

Rice KANSAS

Map No. _____ Sec. 32 Twp. 19 R. 10^W

Well No. 2-S. Wendel "B"₁

Republic Nat. Gas Company
Contractor

CORRECTION

990 Ft. from N. Line
_____ Ft. from S. Line
990 Ft. from E. Line
_____ Ft. from W. Line

CORRECTION

SECTION PLAT

		"A"	
		LSE	
		"B"	0
		LSE	

Location _____

Rig up _____

Drilling and Remarks:

Was # 2-S. Wendel

completed well correct for water

RECORD

Cased _____ in., _____ ft.
Sand _____
Gas _____
Oil _____
Total Depth _____

PRODUCTION

1st 24 hrs. Nat. _____
1st 24 hrs. after shot _____
Gas _____ Cu. Ft.
Dry Hole _____
Abandoned _____

Date

APR 28 1937

19

H. D. Hatfield Scout