


Rice

KANSAS

Section 32 Township 19 Range 10-W

Well Number 5 Mitchell

Company Bradley Oil

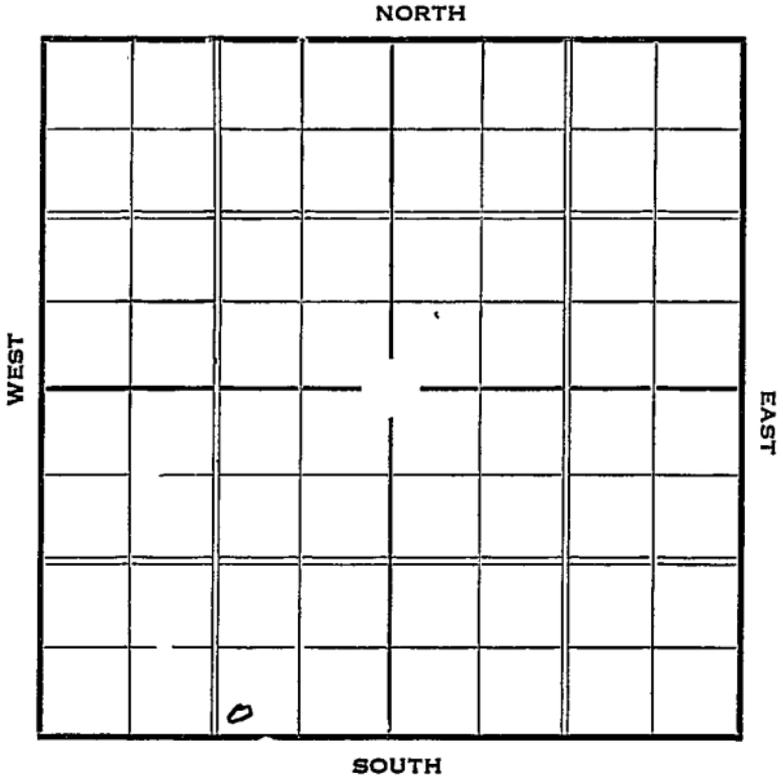

Map No. _____ Sec. 32 Twp. 19 R. 10-W

Well No. #5 Mitchell Farm _____

Bradley Oil Company _____


_____ Ft. from N. Line

330 Ft. from S. Line

990 Ft. from E. Line

_____ Ft. from W. Line

Elev. 1802

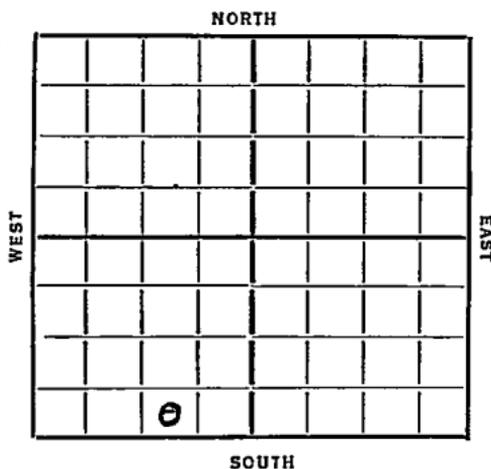

Date	REPORT
<u>1936</u>	
<u>12/29</u>	Location
<u>1937</u>	
<u>1/7</u>	Location
<u>1/14</u>	Ponds.
<u>1/21</u>	"
<u>1/28</u>	"
<u>2/4</u>	"
<u>2/11</u>	Rig
<u>2/18</u>	"
<u>2/26</u>	"
<u>3/4</u>	125' of 10 " Drlg. 300'
<u>3/11</u>	Drlg. 2645'.
<u>3/18</u>	Sil 3295' set 7" RUST
<u>3/25</u>	T.D. 3297½'.
	Potential 816 bbls. 9 hrs.
<u>3/31</u>	Sil. 3295'.
	T. D. 3297½'.
	Potential 2289 natural.
COMPLETED	

Map No. _____ Sec. 32 Twp. 19 R. 10W.

Well No. 5 Mitchell

Bradley Oil Company
Contractor

SECTION PLAT

_____ Ft. from N. Line
330 Ft. from S. Line
990 Ft. from E. Line
_____ Ft. from W. Line

FIRST REPORT

Location ✓

Rig up _____

Drilling and Remarks:

RECORD

Cased _____ in., _____ ft.

Sand _____

Gas _____

Oil _____

Total Depth _____

PRODUCTION

1st 24 hrs. Nat. _____

1st 24 hrs. after shot _____

Gas _____ Cu. Ft.

Dry Hole _____

Abandoned _____

Date

DEC 29 1936 19

S. J. LEWIS Scout

KANSAS *Rice*Map No. _____ Sec. *32* Twp. *19* R. *10W*Well No. *5 Mitchell**Bradley Oil* Company

Contractor _____

SECTION PLAT

_____ Ft. from N. Line

330 Ft. from S. Line*990* Ft. from E. Line

_____ Ft. from W. Line

COMPLETED

RECORD

Location _____

Cased _____ in., _____ ft.

Rig up _____

Sand _____

Drilling and Remarks:

Gas _____

Si 8295

Oil _____

Total Depth *3297 1/2**Potential*

PRODUCTION

1st 24 hrs. Nat. _____

1st 24 hrs. after shot _____

Gas _____ Cu. Ft.

Dry Hole _____

Abandoned _____

Date

MAR 31 1937 19

S. J. LEWIS Scout