


Rice

KANSAS

Section 32 Township 19 Range 10-W

Well Number 7 a. J. Stoltz

Company Gulf

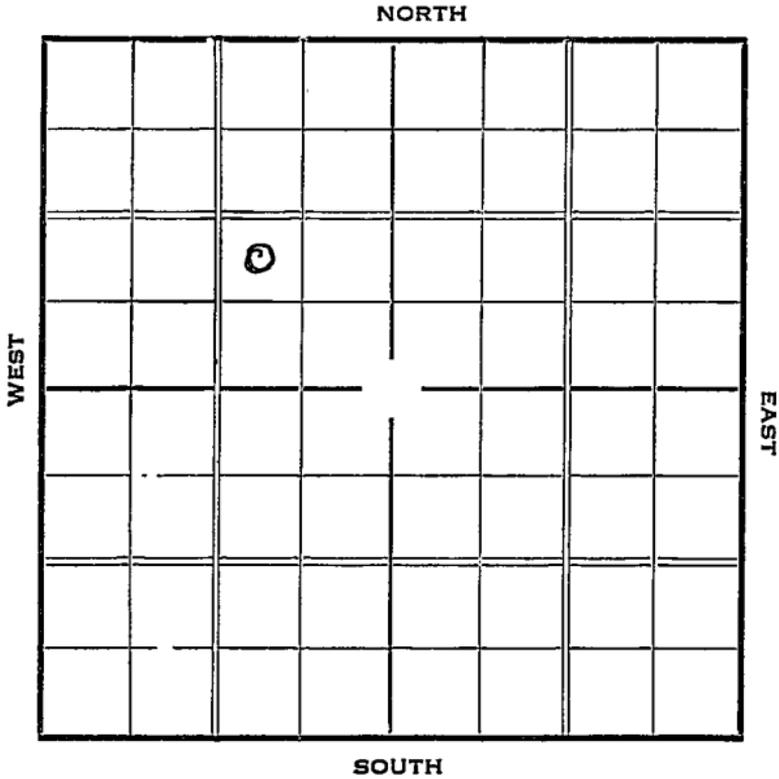

KANSAS

Map No. 46 Sec. 32 Twp. 19 R. 10W.

Well No. 7 a 1/2 St 1/2

Geoff Company

Contractor

SECTION PLAT

	0		

_____ Ft. from N. Line

990 Ft. from S. Line

990 Ft. from E. Line

_____ Ft. from W. Line

FIRST REPORT

Location _____

RECORD

Rig up _____

Drilling and Remarks:

Rig

Cased _____ in., _____ ft.

Sand _____

Gas _____

Oil _____

Total Depth _____

PRODUCTION

1st 24 hrs. Nat. _____

1st 24 hrs. after shot _____

Gas _____ Cu. Ft.

Dry Hole _____

Abandoned _____

Date

JAN 6 1937 19

S. J. LEWIS Scout

Map No. 46 Sec. 32 Twp. 19 R. 10W

Well No. 7. a. J. Stoltz

Gulf Company
Contractor

SECTION PLAT

	o		

_____ Ft. from N. Line

990 Ft. from S. Line

990 Ft. from E. Line

_____ Ft. from W. Line

COMPLETED

Location _____

Rig up _____

Drilling and Remarks:

Sil 3278
P.B 3284
Potential 8770
323 water

RECORD

Cased _____ in., _____ ft.

Sand _____

Gas _____

Oil _____

Total Depth 3286

PRODUCTION

1st 24 hrs. Nat. _____

1st 24 hrs. after shot _____

Gas _____ Cu. Ft.

Dry Hole _____

Abandoned _____

Date

FEB 17 1937 19

S. J. LEWIS Scout