


Section 32 Township 19 Range 10-W

Well Number #6-Stoltz

Company Gulf

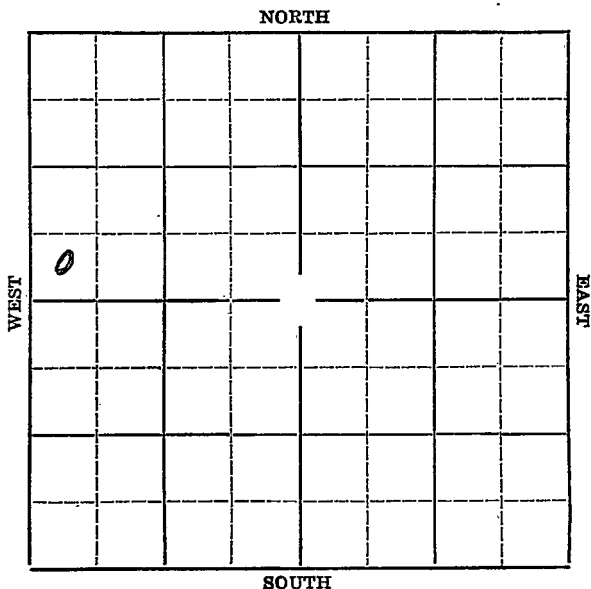

Map No. **KANSAS** Sec. 32 Twp. 19 R. 10-W
Well No. 6-Stoltz Farm
Gulf Company


Ft. from N. Line

330 Ft. from S. Line

Ft. from E. Line

330 Ft. from W. Line

Elev. 1791

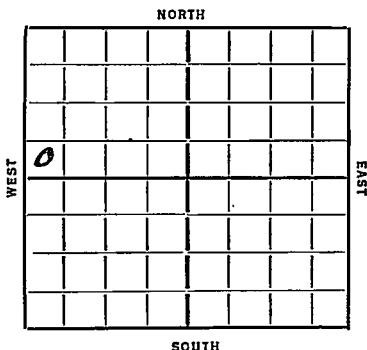

Date
1936

REPORT

4/15 Rig

4/23 Drlg. 385'

4/30 Drlg. 2395'

5/7 Sil. 3275-76'. RUST.

5/14 T.D. 3392'. HFO. Testing.

5/20/36- Sil. 3275'.

T.D. 3292'.

1376 Nat. pot.

COMPLETED

Map No. 46 Sec. 32 Twp. 19 R. 10 N

Well No. 6 Stoltz

G. J. J. Company

Contractor

SECTION PLAT

..... Ft. from N. Line

330 Ft. from S. Line

..... Ft. from E. Line

330 Ft. from W. Line

0			

FIRST REPORT

Location.....

- Rig up.....

Drilling and Remarks:

Rig

RECORD

Cased..... in., ft.

Sand.....

Gas.....

Oil.....

Total Depth.....

PRODUCTION

1st 24 hrs. Nat.....

1st 24 hrs. after shot.....

Gas..... Cu. Ft.

Dry Hole.....

Abandoned.....

Date

APR 15 1936

192.....

S. J. LEWIS

Scout

KANSAS

Map No. 46 Sec. 32 Twp. 19 R. 10WWell No. 6 StoltzGulf. Company

Contractor

SECTION PLAT

0			

_____ Ft. from N. Line

330 Ft. from S. Line

_____ Ft. from E. Line

330 Ft. from W. Line

COMPLETED

Location _____

Rig up _____

Drilling and Remarks:

Oil 32751376 NatProd.

RECORD

Cased _____ in., _____ ft.

Sand _____

Gas _____

Oil _____

Total Depth 3292

PRODUCTION

1st 24 hrs. Nat. 3275

1st 24 hrs. after shot _____

Gas _____ Cu. Ft.

Dry Hole _____

Abandoned _____

Date

MAY 20 1936 19

S. J. LEWIS

Scout