



*Rice*

Map No. KANSAS Sec. 32 Twp. 19 R. 9W

Well No. 1-Adams Farm


max-court oil Company

795 Ft. from N. Line

\_\_\_\_\_ Ft. from S. Line

\_\_\_\_\_ Ft. from E. Line

686 Ft. from W. Line

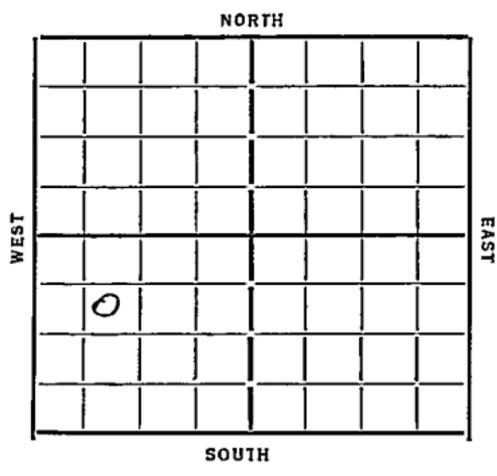

Date  
1933

REPORT

<u>6/14</u>	<u>. Pond</u>
<u>6/21</u>	<u>Bldg Rig</u>
<u>6/28</u>	<u>Rig</u>
<u>7/5</u>	<u>—</u>
<u>7/12</u>	<u>—</u>
<u>7/19</u>	<u>—</u>
<u>7/26</u>	<u>dely 200'</u>
<u>8/2</u>	<u>20" 202' 15" 210 2dely 935'</u>
<u>8/9</u>	<u>12" -1162' dely 1700'</u>
<u>8/17</u>	<u>Top Side 2231 Running 8"</u>
<u>8/23</u>	<u>T.D. 2650 - 4 R. 8"</u>
<u>8/30</u>	<u>4 R. 8" 2504 T.D. 2725'</u>
<u>9/6</u>	<u>6" at 2900 seq 2990</u>
<u>9/13</u>	<u>6" 3178 - Top oil 3218 - oil 3263-67</u>
	<u>1500' oil in 4 hrs - P. B. P.</u>
<u>9/20</u>	<u>no test</u>
<u>9/29</u>	<u>—</u>
<u>10/4</u>	<u>Success 3218</u>
	<u>T.D. 3267 667 bbls oil</u>

COMPLETED

Free  
 Map No. \_\_\_\_\_ Sec. 32 Twp. 19 R. 9W  
 Well No. 1 - Adams

May-Court Oil Co Company  
 \_\_\_\_\_ Contractor

sw sw

SECTION PLAT

795 Ft. from N. Line  
 \_\_\_\_\_ Ft. from S. Line  
 \_\_\_\_\_ Ft. from E. Line  
686 Ft. from W. Line

BEST REPORTS			

Location \_\_\_\_\_  
 Rig up \_\_\_\_\_  
 Drilling and Remarks:

pond

RECORD

Cased \_\_\_\_\_ in., \_\_\_\_\_ ft.  
 Sand \_\_\_\_\_  
 Gas \_\_\_\_\_  
 Oil \_\_\_\_\_  
 Total Depth \_\_\_\_\_

PRODUCTION

1st 24 hrs. Nat. \_\_\_\_\_  
 1st 24 hrs. after shot \_\_\_\_\_  
 Gas \_\_\_\_\_ Cu. Ft.  
 Dry Hole \_\_\_\_\_  
 Abandoned \_\_\_\_\_

Date

6/14/33 192 Orval Mansueti Scott

Map No. 49 Sec. 32 Twp. 19 R. 9W

Well No. 1-Adams

May Court Company

Contractor

SECTION PLAT

795 Ft. from N. Line

..... Ft. from S. Line

..... Ft. from E. Line

686 Ft. from W. Line


**COMPLETED**

Location.....

Rig up.....

Drilling and Remarks:

667 lbs  
oil

RECORD

Cased..... in., ..... ft.

Sand silicious 3218

Gas.....

Oil.....

Total Depth 3267

PRODUCTION

1st 24 hrs. Nat.....

1st 24 hrs. after shot.....

Gas..... Cu. Ft.

Dry Hole.....

Abandoned.....

Date OCT

4 1933  
192

O. Manscheck Scott