

# KANSAS

Form 51-5M-7-39-Palace


Rice

Section 32 Township 19 Range 9-W

Well No. #1 Barngrover

Company D. C. Robertson

NORTH Chase Pool

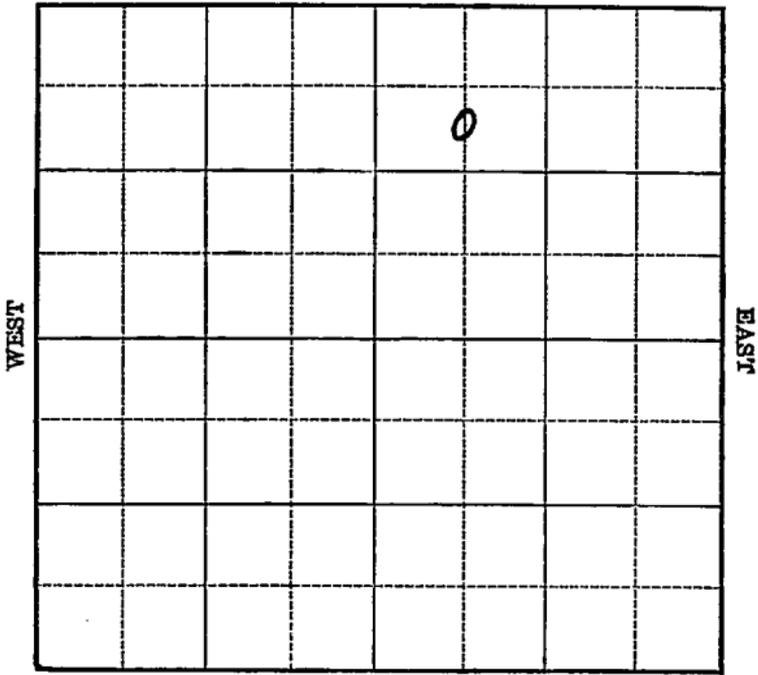

SOUTH



Map No. 49 Sec. 32 Twp. 19 R. 9WWell No. 1 BarngroverD. C. Robertson

Company

Contractor

## FIRST REPORT

## SECTION PLAT

990 C S L NW NE  
Ft. from N. Line

Ft. from S. Line

Ft. from E. Line

660 Ft. from W. Line

CHASE POOL


Location \_\_\_\_\_

Rig up \_\_\_\_\_

Drilling and Remarks:

Cable

## RECORD

Cased \_\_\_\_\_ in., \_\_\_\_\_ ft.

Sand \_\_\_\_\_

Gas \_\_\_\_\_

Oil \_\_\_\_\_

Total Depth \_\_\_\_\_

## PRODUCTION

1st 24 hrs. Nat. \_\_\_\_\_

1st 24 hrs. after shot \_\_\_\_\_

Gas \_\_\_\_\_ Cu. Ft.

Dry Hole \_\_\_\_\_

Abandoned \_\_\_\_\_

Date

MAR 13 1940

19

S. J. LEWIS

Scout

Map No. 49 Sec. 32 Twp. 19 R. 9WWell No. 1 BarngroverD. C. Robertson Company

Contractor

ABANDONED

C S L NW NE

990 Ft. from N. Line

\_\_\_\_\_ Ft. from S. Line

\_\_\_\_\_ Ft. from E. Line

660 Ft. from W. Line

CHASE POOL

## SECTION PLAT

		o	

Location \_\_\_\_\_

Rig up \_\_\_\_\_

Drilling and Remarks:

*CR 3230**5" @ 3230**HFW*

## RECORD

Cased \_\_\_\_\_ in., \_\_\_\_\_ ft.

Sand \_\_\_\_\_

Gas \_\_\_\_\_

Oil \_\_\_\_\_

Total Depth 3322

## PRODUCTION

1st 24 hrs. Nat. \_\_\_\_\_

1st 24 hrs. after shot \_\_\_\_\_

Gas \_\_\_\_\_ Cu. Ft.

Dry Hole \_\_\_\_\_

Abandoned \_\_\_\_\_

Date

APR 24 1940 19S. J. LEWIS

Scout