


Section 32 Township 19 Range 9-W

Well Number #3 Brunkan

Company Torrey & Feaster

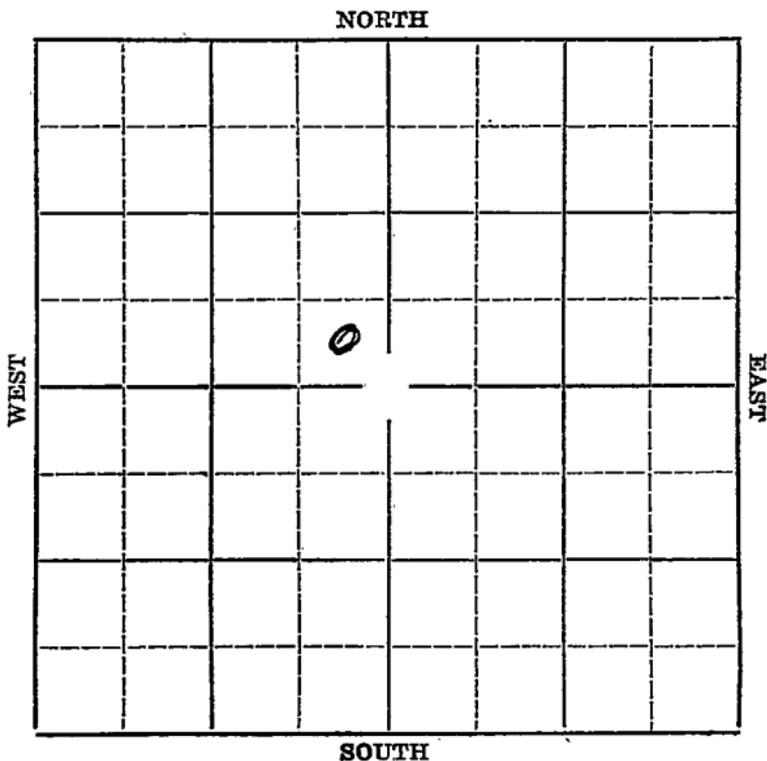

O. W. D. D

Map No. KANSAS Sec. 32 Twp. 19 R. 9W

Well No. #3 Brunkan Farm

Torrey & Feaster. Company


_____ Ft. from N. Line

330' Ft. from S. Line

330' Ft. from E. Line

_____ Ft. from W. Line

Elev. 1718

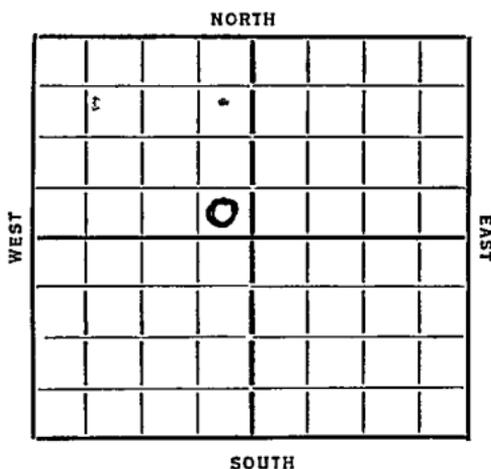

Date	REPORT	O. W. D. D
1936		
7/15	Location	
7/23	--	
7/30	Machine.	
8/6	-- 8/13-- 8/20--	
8/27	12" @ 295'. Clean out.	
9/3	Drlg. 1235'.	
9/10	Drlg. 1580'.	
9/18	10" @ 1674'. Drlg. 1982'.	
9/24	8" @ 2490'. Fishing.	
10/1	--	
10/8	8" @ 2513'. Drlg. 2525'.	
10/15	Drlg. 2905'.	
10/22	2-Sil. 3320'. T.D. 3239'. 1000 gals of acid.	
10/29	Rigging up to clean out.	
11/4	Sil. 3220 1000 acid	
	Total Depth 3239	
	Pot. 395	
	COMPLETED	
	OVER	

O. W. D. D

1936

12/29

Old T. D. 3239'.

T. D. 3250'.

Acidize 1500.

Pot. 480!

FIRST REPORTS

and

COMPLETED

Rice

Map No. 49 Sec. 32 Twp. 19 R. 9W

Well No. 3 Brumhan

Toery & Feaster Company

Contractor

SECTION PLAT

_____ Ft. from N. Line

330 Ft. from S. Line

330 Ft. from E. Line

_____ Ft. from W. Line

FIRST REPORT

Location ✓

Rig up _____

Drilling and Remarks:

RECORD

Cased _____ in., _____ ft.

Sand _____

Gas _____

Oil _____

Total Depth _____

PRODUCTION

1st 24 hrs. Nat. _____

1st 24 hrs. after shot _____

Gas _____ Cu. Ft.

Dry Hole _____

Abandoned _____

Date

JUL 15 1936₁₉

S. J. LEWIS

Scout

[Handwritten scribble]

Returned	<i>[Signature]</i>
Cards	<i>[Signature]</i>
Tracing	<i>[Signature]</i>
France Map	<i>[Signature]</i>
Scarborough Map	<i>[Signature]</i>
Moody Map	
Scarborough Plat Book	
Moody Plat Book	

KANSAS

Map No. 49 Sec. 32 Twp. 19 R. 9W

Well No. 3 Bunker

Torrey & Frates Company

Contractor

SECTION PLAT

_____ Ft. from N. Line

330 Ft. from S. Line

330 Ft. from E. Line

_____ Ft. from W. Line

COMPLETED

Location _____

Rig up _____

Drilling and Remarks:

Sil 3220
100 acid
P 8395

RECORD

Cased _____ in., _____ ft.

Sand _____

Gas _____

Oil _____

Total Depth 3239

PRODUCTION

1st 24 hrs. Nat. _____

1st 24 hrs. after shot _____

Gas _____ Cu. Ft.

Dry Hole _____

Abandoned _____

Date

NOV 4 1936 19

S. J. LEWIS Scout

[Handwritten scribbles and lines]

Returned	
Cards	<i>[Handwritten initials]</i>
Tracing	<i>[Handwritten initials]</i>
France Map	<i>[Handwritten initials]</i>
Scarborough Map	<i>[Handwritten initials]</i>
Moody Map	<i>[Handwritten initials]</i>
Scarborough Post Box	
Moody Post Box	

Map No. 49 Sec. 32 Twp. 19 R. 9W.

Well No. 3 Brunken

Thorrey & Feaster Company

Contractor

SECTION PLAT

_____ Ft. from N. Line

330 Ft. from S. Line

330 Ft. from E. Line

_____ Ft. from W. Line

**FIRST REPORT
COMPLETED**

OW-117

Location _____

Rig up _____

Drilling and Remarks:

OW-117 3239

1500 acid

P 4480

RECORD

Cased _____ in., _____ ft.

Sand _____

Gas _____

Oil _____

Total Depth 3250

PRODUCTION

1st 24 hrs. Nat. _____

1st 24 hrs. after shot _____

Gas _____ Cu. Ft.

Dry Hole _____

Abandoned _____

Date

DEC 29 1935

19

S. J. LEWIS

Scout

Handwritten signature and scribbles

Returned
Cards	<i>Paul</i>
Tracing	<i>Joe</i>
France Map	<i>[Signature]</i>
Scarborough Map	<i>[Signature]</i>
Moody Map
Scarborough Plat Book
Moody Plat Book