


Rice

Map No. _____ Sec. 32 Twp. 19 R. 9⁴⁰

Well No. 1 H.O. Brunkan Farm
Terry & Leaster (Brunkan) Company

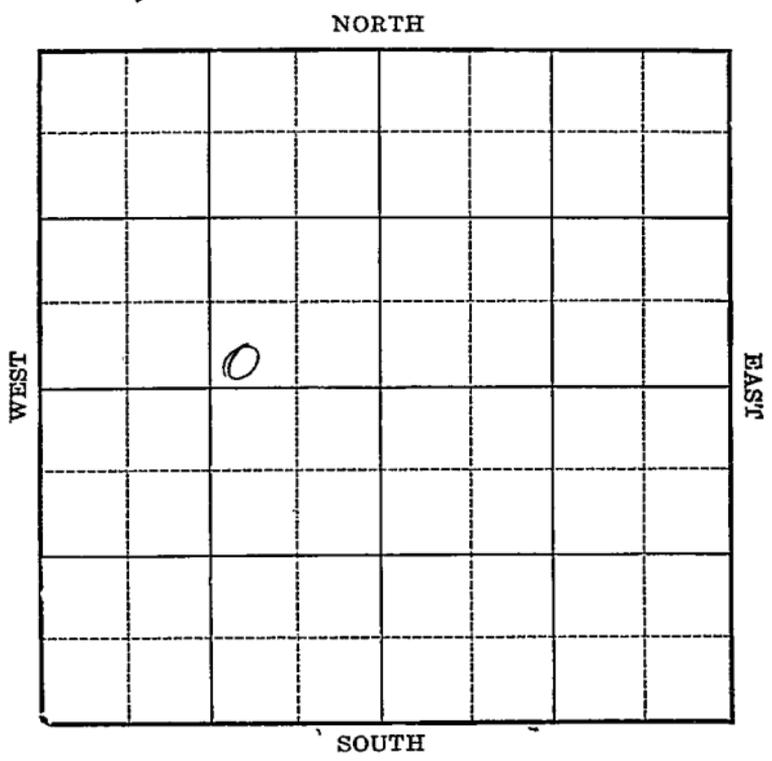

Location _____

Drilling Remarks _____

Rig Up _____

Drilling Remarks _____

RECORD

Cased _____ in. _____ ft.

Sand _____

Gas _____

Oil _____

Total Depth _____

PRODUCTION

1st 24 hrs. Nat. _____

1st 24 hrs. after shot _____

Gas _____ cu. ft.

Dry Hole _____

Abandoned _____

Rice

Map No. KANSAS Sec. 32 Twp. 19 R. 90

Well No. 1 - H. O. Brunban Farm


Jarney Keaster Company

_____ Ft. from N. Line

330' Ft. from S. Line

990' Ft. from E. Line

_____ Ft. from W. Line

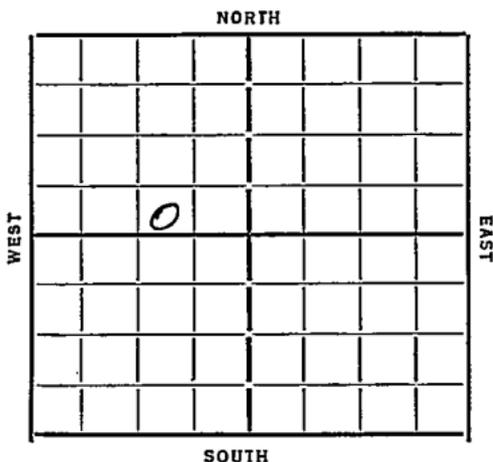

Date 1933

REPORT

12/6 Mooring Material

12/27 _____

1/11 15" at 160 - dreg 165

1/17 12" at 670

1/24 dreg 1390

1/31 " 1720

2/7 " 1950

2/14 " 2590

2/23 2990 SD Running 6"

3/1 Conj. 3232 Sill 3245

750 3255 3100' oil

3/8 P. B. P

3/14 Silicone 3245 75 3255

600 Able Pot

COMPLETED

Map No. 49 Sec. 32 Twp. 19 R. 9W

Well No. 1- H. O. Brunkaw
Tarrey & Greaster Company

Contractor

FIRST REPORTS
sw

SECTION PLAT

	0		

..... Ft. from N. Line

330 Ft. from S. Line

990 Ft. from E. Line

..... Ft. from W. Line

Location.....

Rig up.....

Drilling and Remarks:

moving in material

RECORD

Cased..... in., ft.

Sand.....

Gas.....

Oil.....

Total Depth.....

PRODUCTION

1st 24 hrs. Nat.....

1st 24 hrs. after shot.....

Gas..... Cu. Ft.

Dry Hole.....

Abandoned.....

Date

12-6-33 192 O. Mannerhook Scout

no wall

Returned	
Cards	<i>MB</i>
Tracing	<i>OK</i>
France Map	X
Scarborough Map	X
Moody Map	X
Scarborough, Flat Book	
Moody Plat Book	

Map No. 49 Sec. 37 Twp. 19 R. 9W

Well No. 1-Brunkan

Tarrey & Measter Company

Contractor

COMPLETED

SECTION PLAT

.....Ft. from N. Line

330 Ft. from S. Line

990 Ft. from E. Line

.....Ft. from W. Line

	0		

Location.....

Rig up.....

Drilling and Remarks:

*600 hpl
pot*

RECORD

Cased.....in.,ft.

Sand silicious 3245

Gas.....

Oil.....

Total Depth 3255

PRODUCTION

1st 24 hrs. Nat.....

1st 24 hrs. after shot.....

Gas.....Cu. Ft.

Dry Hole.....

Abandoned.....

Date

3-14-34 O. Mannschreck Scott

no wall

Returned	
Cards	<i>RDP</i>
Tracing	<i>CRK</i>
Frame Map	<i>X</i>
Scotchboro Map	<i>X</i>
Map	<i>X</i>
Map	<i>X</i>
Map	<i>X</i>
Map	<i>X</i>