

Map No. KANSAS Sec. 32 Twp. 19 R. 9W

Well No. 1-Callis Farm _____

Derby Oil Company _____


_____ Ft. from N. Line

330 Ft. from S. Line

495 Ft. from E. Line

_____ Ft. from W. Line

Elev. 1709

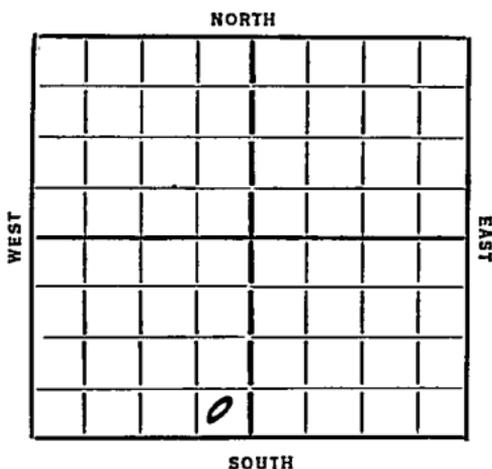

REPORT

~~1936~~
1936
3/11

Location

3/20 Building rotary rig.

3/27 Spud.

4/2 12" - 193' Drlg. 1685'.

4/10 Drlg. 2725'

4/16 Sil. 3239' 5" @ 3240' T.D. 3255'

RUST.

4/23 --

4/30 T.D. 3276'. P.B. 3274½'. 1000 acid.

5 bbls. per hour.

5/6/36 - Sil. 3239'

T.D. 3276'

1000 acid.

140 bbls oil.

21 bbls water.

COMPLETED

Map No. 49 Sec. 32 Twp. 19 R. 9W

Well No. 1-Callis

Derby oil Company

Contractor

FIRST REPORTS

..... Ft. from N. Line

330 Ft. from S. Line

495 Ft. from E. Line

..... Ft. from W. Line

SECTION PLAT

Location

Rig up

Drilling and Remarks:

RECORD

Cased..... in., ft.

Sand.....

Gas.....

Oil.....

Total Depth.....

PRODUCTION

1st 24 hrs. Nat.....

1st 24 hrs. after shot.....

Gas..... Cu. Ft.

Dry Hole.....

Abandoned.....

Date

ORVAL MANNSCHRECK

3-11-36 192.....

Scout

Map No. 49 Sec. 32 Twp. 19 R. 2W

Well No. 1 Callis

Deery Company
Contractor

SECTION PLAT

_____ Ft. from N. Line
280 Ft. from S. Line
495 Ft. from E. Line
_____ Ft. from W. Line

COMPLETED

Location _____

Rig up _____

Drilling and Remarks:

Oct 3239
1000 acid
140 8 1/2 oil
21 " Water

RECORD

Cased _____ in., _____ ft.
Sand _____
Gas _____
Oil _____
Total Depth 3276

PRODUCTION

1st 24 hrs. Nat. _____
1st 24 hrs. after shot _____
Gas _____ Cu. Ft.
Dry Hole _____
Abandoned _____

Date

MAY 6 1923

S. J. LEWIS

Scout