


Section 32 Township 19 **KANSAS** Range 9-W

Well Number 1 Callis

Company E.B.Holland et al

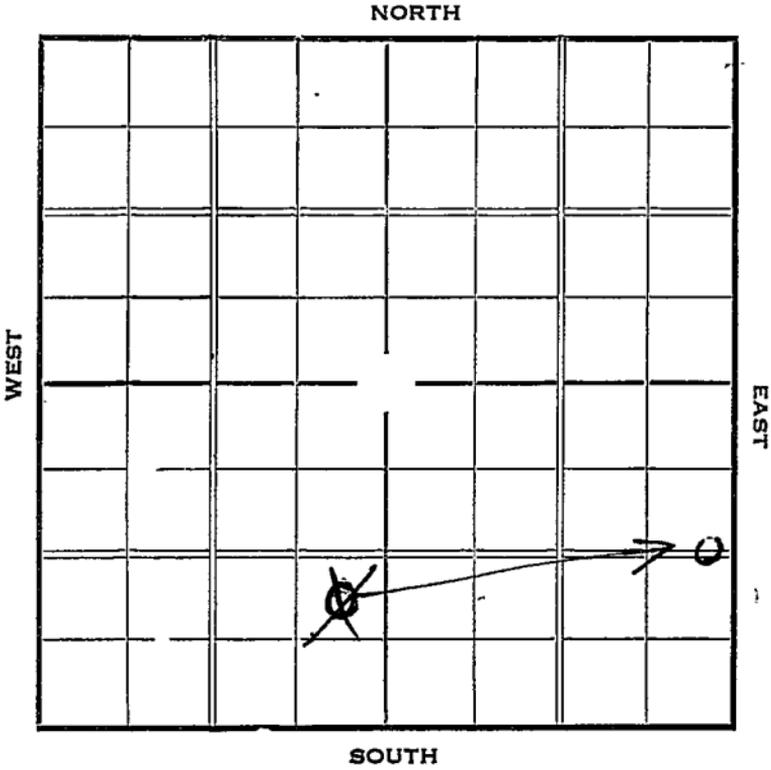

Map No. \_\_\_\_\_ Sec. 32 Twp. 19 R. 9-W

Well No. #1 Callis Farm \_\_\_\_\_


E. B. Holland et al Company \_\_\_\_\_

\_\_\_\_\_ Ft. from N. Line

1320  
990 Ft. from S. Line

330 Ft. from E. Line

\_\_\_\_\_ Ft. from W. Line

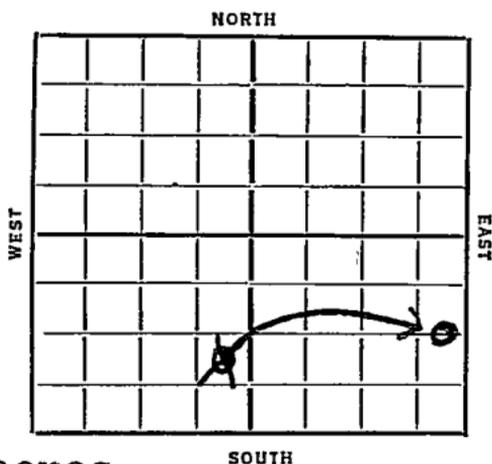

North  $\frac{1}{2}$  Derby 10 acres.

1936 ~~REPORT~~ REPORT

12/22 Rig

12/29 "

1937

1/7 Rigging up

1/14 Spud.

1/21 15" @ 191'. 12" @ 1168'.

T. D. 1175' Clean out.

1/28 Drlg. 1800'.

2/4 Drlg. 2200'

2/11 10" @ 2206, 2490 fishing

2/18 8" @ 2795'. KCL 2900'.

Drlg. 3105'.

2/26 Drlg. 3320'.

3/3 Conglomerate 3200'.

Sil. 3253'.

Water 3263'.

T. D. 3320'.

**ABANDONED**

# KANSAS

Map No. 49 Sec. 32 Twp. 19 R. 9W

Well No. 1 Callis

E. B. Holland & Co. Company

Contractor

## SECTION PLAT


\_\_\_\_\_ Ft. from N. Line

990 Ft. from S. Line

280 Ft. from E. Line

\_\_\_\_\_ Ft. from W. Line

## FIRST REPORT

Location \_\_\_\_\_

Rig up \_\_\_\_\_

Drilling and Remarks:

*Rig*  
*North 1/2 Derby 10 acres*

## RECORD

Cased \_\_\_\_\_ in., \_\_\_\_\_ ft.

Sand \_\_\_\_\_

Gas \_\_\_\_\_

Oil \_\_\_\_\_

Total Depth \_\_\_\_\_

## PRODUCTION

1st 24 hrs. Nat. \_\_\_\_\_

1st 24 hrs. after shot \_\_\_\_\_

Gas \_\_\_\_\_ Cu. Ft.

Dry Hole \_\_\_\_\_

Abandoned \_\_\_\_\_

Date

DEC 22 1936 19

S. J. LEWIS Scout

Map No. 49 Sec. 32 Twp. 19 R. 9W

Well No. 1 Callie

Holland & Co Company

Contractor

**SECTION PLAT**

			0

\_\_\_\_\_ Ft. from N. Line

1320 Ft. from S. Line

330 Ft. from E. Line

\_\_\_\_\_ Ft. from W. Line

**CORRECTION**

Location \_\_\_\_\_

Rig up \_\_\_\_\_

Drilling and Remarks:

*Reported  
No SE 84.*

**RECORD**

Cased \_\_\_\_\_ in., \_\_\_\_\_ ft.

Sand \_\_\_\_\_

Gas \_\_\_\_\_

Oil \_\_\_\_\_

Total Depth \_\_\_\_\_

**PRODUCTION**

1st 24 hrs. Nat. \_\_\_\_\_

1st 24 hrs. after shot \_\_\_\_\_

Gas \_\_\_\_\_ Cu. Ft.

Dry Hole \_\_\_\_\_

Abandoned \_\_\_\_\_

Date

JAN 6 1937 19

S. J. LEWIS

Scout

Map No. 49 Sec. 32 Twp. 19 R. 9W

Well No. 1 Callis

Holland & Gal Company

Contractor

### SECTION PLAT


         Ft. from N. Line  
1320 Ft. from S. Line  
330 Ft. from E. Line  
         Ft. from W. Line

## ABANDONED

Location         

Rig up         

Drilling and Remarks:

*Conglomerate*  
*3200*  
*Sil 3253*  
*Water 3263*

### RECORD

Cased          in.,          ft.  
Sand           
Gas           
Oil           
Total Depth 3220

### PRODUCTION

1st 24 hrs. Nat.           
1st 24 hrs. after shot           
Gas          Cu. Ft.  
Dry Hole          ✓  
Abandoned          ✓

Date

MAR 3 1937 19

S. J. LEWIS Scout