




Rice

Map No. \_\_\_\_\_ Sec. 32 Twp. 19 R. 9<sup>W</sup>

Well No. 1 Low Farm \_\_\_\_\_  
Ramsey et al Company

1020' Ft. from N. Line  
\_\_\_\_ Ft. from S. Line  
\_\_\_\_ Ft. from E. Line  
270' Ft. from W. Line

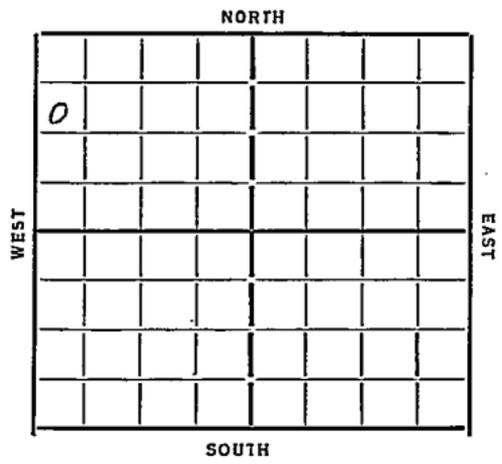

Date 1933

REPORT

- 4/12 Bldg Rig
- 4/19 Rigging up
- 4/26 spud
- 5/4 drlg 785'
- 5/10 20" -190' 15" -211 -12" 1063' log 1165'
- 5/17 4" drlg 1690'
- 5/24 10" 1823 - 8" 2243 drlg 2500'
- 6/1 5" 2980
- 6/8 Top hole over 3244 T.D. 3270  
2600 oil 8 hrs
- 6/15 T.D. 3270 swab 470 bbls 12 hrs P.B.P
- 6/21 testing
- 6/28 —
- 7/5 Top hole over 3244 pump  
31 bbls per hour  
T.D. 3270'

Completed

COMPLETED

49 **KANSAS** Rice  
 Map No. Sec. 32 Twp. 19 R. 9 W

Well No. 1 Tra  
 Ramsey Co al Company

Contractor

### FIRST REPORTS

1020 Ft. from N. Line

..... Ft. from S. Line

..... Ft. from E. Line

270 Ft. from W. Line

### SECTION PLAT

0			

Location.....

Rig up.....

Drilling and Remarks:

Blog Rig

### RECORD

Cased.....in., .....ft.

Sand.....

Gas.....

Oil.....

Total Depth.....

### PRODUCTION

1st 24 hrs. Nat.....

1st 24 hrs. after shot.....

Gas.....Cu. Ft.

Dry Hole.....

Abandoned.....

Date

APR 12 1933

192 CHAS. L. SHERWOOD  
 Scout

Map No. \_\_\_\_\_ Sec. 32 Twp. 19 R. 9W  
 Well No. 49 Tra  
Ramsay et al Company  
 \_\_\_\_\_ Contractor

SECTION PLAT

1020 Ft. from N. Line  
 \_\_\_\_\_ Ft. from S. Line  
 \_\_\_\_\_ Ft. from E. Line  
270 Ft. from W. Line

o			

**COMPLETED**

Location \_\_\_\_\_  
 Rig up \_\_\_\_\_  
 Drilling and Remarks:

Siliceous 3244

Pump 31 fols per hour

RECORD

Cased \_\_\_\_\_ in., \_\_\_\_\_ ft.  
 Sand \_\_\_\_\_  
 Gas \_\_\_\_\_  
 Oil \_\_\_\_\_  
 Total Depth 3270

PRODUCTION

1st 24 hrs. Nat. \_\_\_\_\_  
 1st 24 hrs. after shot \_\_\_\_\_  
 Gas \_\_\_\_\_ Cu. Ft.  
 Dry Hole \_\_\_\_\_  
 Abandoned \_\_\_\_\_

Date \_\_\_\_\_

7-27-33 192 Coal Mansfield Scout