

Rice

Map No. KANSAS Sec. 32 Twp 19 R. 9W

Well No. 2 In Farm


Ramsey Pet. Company

990 Ft. from N. Line

_____ Ft. from S. Line

_____ Ft. from E. Line

990 Ft. from W. Line

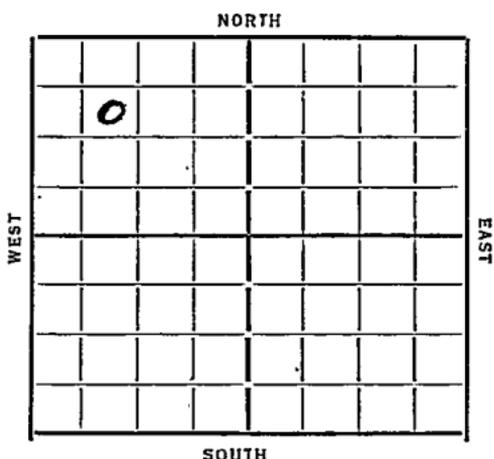

Date 1924

REPORT

5/16 Bldg Rig
 5/25 Rign up
 5/31 ddy 770
 6/7 Run 10" 1906
 6/14 ddy 2745
 6/21 " 3140
 6/28 6" 3187 Cong. 3230
 Siliceous 3251 TD 3275
 500' oil 1000 acid
 Avst 3 Bbls per hr.
 7/3 Siliceous 3251 TD 3275
 232 Bbls.

COMPLETED

Map No. 49 Sec. 32 Twp. 19 R. 9W

Well No. 2-2a

Ramsay Pit Company

Contractor

FIRST REPORTS

SECTION PLAT

990 Ft. from N. Line
____ Ft. from S. Line
____ Ft. from E. Line
990 Ft. from W. Line

0			

Location _____

Rig up _____

Drilling and Remarks:

Bed Rig

RECORD

Cased _____ in., _____ ft.

Sand _____

Gas _____

Oil _____

Total Depth _____

PRODUCTION

1st 24 hrs. Nat. _____

1st 24 hrs. after shot _____

Gas _____ Cu. Ft.

Dry Hole _____

Abandoned _____

Date

5-16-34 19

ORVAL MANNSCHRECK

Scout

Map No. 49 Sec. 32 Twp. 19 R. 9W

Well No. 2-2a

Ramsey Company
Contractor

~~CONFIDENTIAL~~

SECTION PLAT

0			

990 Ft. from N. Line

_____ Ft. from S. Line

_____ Ft. from E. Line

990 Ft. from W. Line

Location _____

Rig up _____

Drilling and Remarks:

232 bbls

RECORD

Cased _____ in., _____ ft.

Sand 325'

Gas _____

Oil _____

Total Depth 3275

PRODUCTION

1st 24 hrs. Nat. _____

1st 24 hrs. after shot _____

Gas _____ Cu. Ft.

Dry Hole _____

Abandoned _____

Date

7-3-34 19

ORVAL MANNSCHRECK

Scout