


Map No. 24 SAS Sec. 32 Twp. 19 R. 9W
 Well No. 1 G. Johnson Farm
Ramsey Company

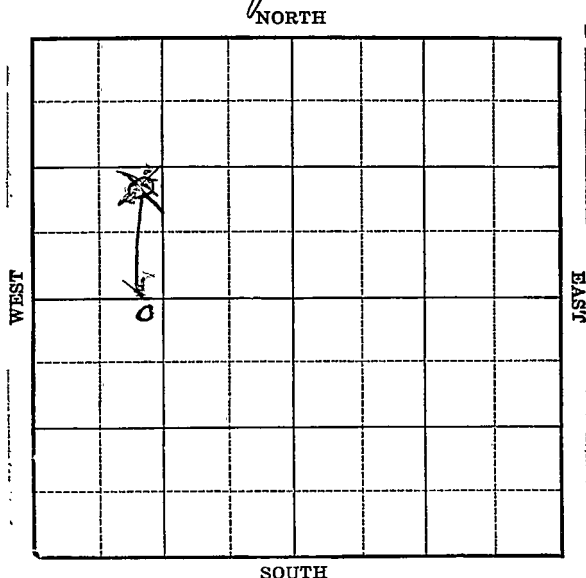

Location _____

Drilling Remarks _____

RECORD .

Cased _____ in. _____ ft.

Sand _____

Gas _____

Oil _____

Total Depth _____

Rig Up _____

Drilling Remarks _____

PRODUCTION

1st 24 hrs. Nat. _____

1st 24 hrs. after shot _____

Gas _____ cu. ft. _____

Dry Hole _____

Abandoned _____

Rice

Map No. **KANSAS** Sec. *32* Twp. *19* R. *9N*


Well No. *1- J. Johnson* Farm
Ramsey Company

80 Ft. from N. Line

~~*1188*~~ Ft. from S. Line

Ft. from E. Line

1240
~~*1279*~~ Ft. from W. Line

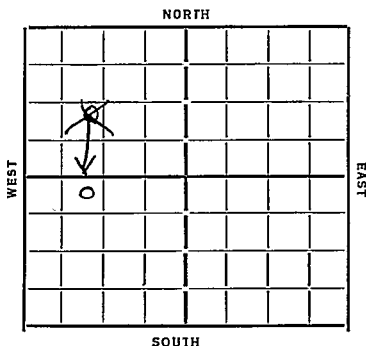

Date *1934*

REPORT

1/31 *Cellar*
2/7 *—*
2/14 *Spud*
2/23 *Drly 800 20" 183 15 1/2" 450*
3/1 *" 1790*
3/8 *" 2746 10" 1917 5 1/2" 450*
2210-30
3/15 *Drly 3133*
3/22 *Sil 3277-3301 HFW 3296*
PB 3294 5 Oil 30 Water
3/28 *Siliceous 3277 4D 3301*
dry & abandoned.

ABANDONED

Price
 Map No. 49 Sec. 32 Twp. 19 R. 9W
 Well No. #1- T. Johnson
Bamsey Company

Contractor

FIRST REPORTS

Ft. from N. Line

1188 Ft. from S. Line

Ft. from E. Line

1249 Ft. from W. Line

SECTION PLAT

0			

Location.....

Rig up.....

Drilling and Remarks:

cellar

RECORD

Cased.....in., ...ft.

Sand.....

Gas.....

Oil.....

Total Depth.....

PRODUCTION

1st 24 hrs. Nat.....

1st 24 hrs. after shot.....

Gas.....Cu. Ft.

Dry Hole.....

Abandoned.....

Date

1-31-34 192 O. Mammescheck Scout

Map No. 49 Sec. 32 Twp. 19 R. 9W


Well No. 1-T. Johnson

Barnsey Company

Contractor

CORRECTION

SECTION PLAT

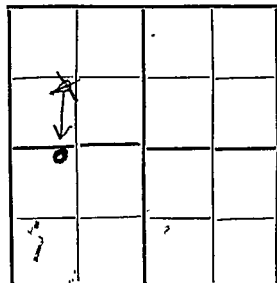

80 Ft. from N. Line

_____ Ft. from S. Line

_____ Ft. from E. Line

1240 Ft. from W. Line

Location _____

Rig up _____

Drilling and Remarks:

*formerly reported
in new quarter
1188 S
1249 W*

CORRECTION

RECORD

Cased _____ in., _____ ft.

Sand _____

Gas _____

Oil _____

Total Depth _____

PRODUCTION

1st 24 hrs. Nat. _____

1st 24 hrs. after shot _____

Gas _____ Cu. Ft.

Dry Hole _____

Abandoned _____

Date

2-7-34 192 O. Marmescheck Scout

Map No. 49 Sec. 32 Twp. 19 R. 9W

Well No. 1-T. Johnson

Ramsey Company

ABANDONED Contractor

SECTION PLAT

80 Ft. from N. Line

..... Ft. from S. Line

..... Ft. from E. Line

1240 Ft. from W. Line

0			

Location.....

Rig up.....

Drilling and Remarks:

10 V #

RECORD

Cased: 3 in., ... ft.

Sand silicious 3277

Gas.....

Oil.....

Total Depth 3301

PRODUCTION

1st 24 hrs. Nat.....

1st 24 hrs. after shot.....

Gas..... Cu. Ft.

Dry Hole.....

Abandoned.....

Date

3/28/37 192 O. Mammuch Scout