



Rice

KANSAS

Map No. \_\_\_\_\_ Sec. 32 Twp. 19 R. 9<sup>w</sup>

Well No. #1 City Park Farm \_\_\_\_\_


Ramsey Company \_\_\_\_\_

75' Ft. from N. Line

\_\_\_\_\_ Ft. from S. Line

\_\_\_\_\_ Ft. from E. Line

10/0' Ft. from W. Line

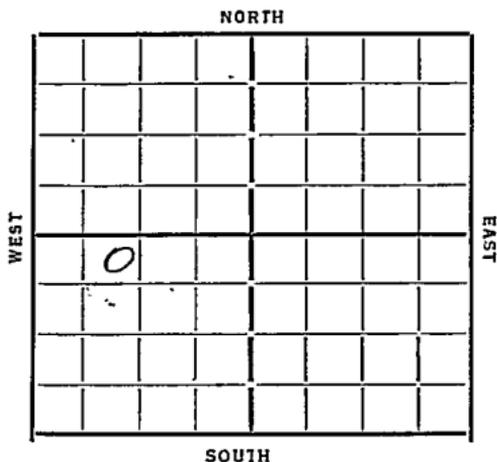

Date 7/9/33

REPORT

7/5 Location  
 7/12 20" - 208 dely 325  
 7/19 12" - 1187 dely 1390'  
 7/26 10" 1920' Reen 8" 2244  
 8/2 N.T.W. 2240' 8" dely 2825'  
 8/9 6" 3106 T.D. 3238 finishing  
 8/17 Top silicious 3248 T.D. 3254 Q.O.  
 8/22 T.D. 3275 swab 300 bbls 24 hrs  
 8/30 Silicious 3248-3275  
 pump 200 bbls oil  
 3% water

COMPLETED

Map No. 49 Sec. 32 Twp. 19 R. 9W

Well No. #1 - City park

Ramsey Company

Contractor


**SECTION PLAT**

75 Ft. from N. Line

..... Ft. from S. Line

..... Ft. from E. Line

1010 Ft. from W. Line

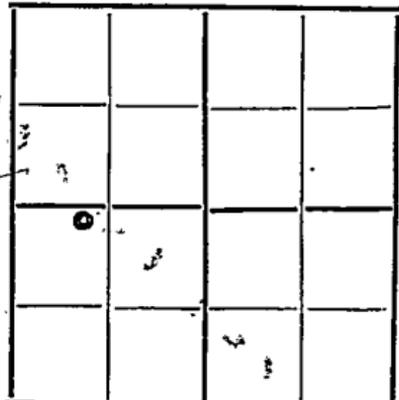

**FIRST REPORTS**

Location

Rig up.....

Drilling and Remarks:

**RECORD**

Cased..... in., ..... ft.

Sand.....

Gas.....

Oil.....

Total Depth.....

**PRODUCTION**

1st 24 hrs. Nat.....

1st 24 hrs. after shot.....

Gas..... Cu. Ft.

Dry Hole.....

Abandoned.....

Date

7/5/33 192 Oval Mansch

Map No. 49 Sec. 32 Twp. 19 R. 9W

Well No. 1 - City park

Ramsey Company

Contractor

SECTION PLAT


75 Ft. from N. Line

..... Ft. from S. Line

..... Ft. from E. Line

1010 Ft. from W. Line

**COMPLETED**

Location.....

Rig up.....

Drilling and Remarks:

Pump 200  
bbbs + 3% Water

RECORD

Cased..... in., ..... ft.

Sand delicious 3248

Gas.....

Oil.....

Total Depth 3275

PRODUCTION

1st 24 hrs. Nat.....

1st 24 hrs. after shot.....

Gas..... Cu. Ft.

Dry Hole.....

Abandoned.....

Date

8/30/33<sub>192</sub> O. Mannes Secut