

KANSAS

Rice

Section 32 Township 19 Range 9W

Well No. 1 Hurt

Company Skelly

Chase

NORTH

WEST

EAST

						0	

SOUTH

Rice

KANSAS



Sec. 32 Twp. 19 R. 9W

Well No. #1 Hurt Farm

Skelly Company


Chase Pool

330' Ft. from N. Line

 Ft. from S. Line

990' Ft. from E. Line

 Ft. from W. Line

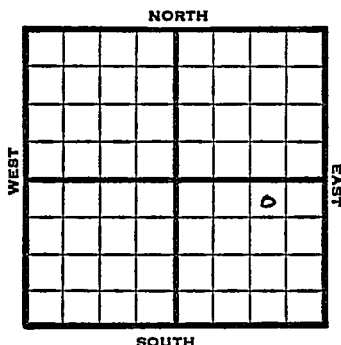

NW NE SE

1949

Elev. 1698'

R E P O R T

6/8

Location

6/15

8"@ 310'

Drlg 2240'

6/22

Lans. 2897'

Cong. 3198'

Arb. 3234'

TD 3251'

ABANDONED

Rice County Kansas State

Map No. _____ Sec. 32 Twp. 19 R. 9W

Well No. 1 Hurt

Skelly Company

Contractor

NW NE SE


**FIRST REPORT
SECTION PLAT**

330 Ft. from N. Line

Ft. from S. Line

990 Ft. from E. Line

Ft. from W. Line

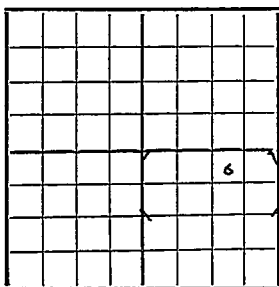

Chase Pool

Remarks:

Location

Date JUN 8 1949

Scout

S. J. LEWIS

Kansas

Map No. K49 Sec. 32 Twp. 19 R. 9WWell No. 1 Hurt

Skelly

Company

ABANDONED

Contractor

NW NE SE

E1. 1698
SECTION PLAT330 Ft. from N. Line

Ft. from S. Line

990 Ft. from E. Line

Ft. from W. Line

			0

Rice County

RECORD

Location

Cased _____ in., _____ ft.

Rig up

Sand

Drilling and Remarks:

Gas

Oil

Total Depth 3251

PRODUCTION

1st 24 hrs. Nat.

1st 24 hrs. after shot

Gas _____ Cu. Ft.

Dry Hole

Abandoned

Date

JUN 22 1949

19

S. J. LEWIS

Scout