

Map No. KANSAS

Well No.

Company

NORTH

WEST

EAST

SOUTH

0

Rig Up

Drilling Remarks

PRODUCTION

1st 24 hrs. Nat.-----

1st 24 hrs. after shot-----

Gas -----cu. ft.-----

Dry Hole_____

Abandoned_____

Rice

Map No. KANSAS Sec. 32 Twp 19 R. 9W

Well No. 3 *Ira* Farm


Ramsey Pet. Company

Ft. from N. Line

1850 Ft. from S. Line

Ft. from E. Line

1980 Ft. from W. Line

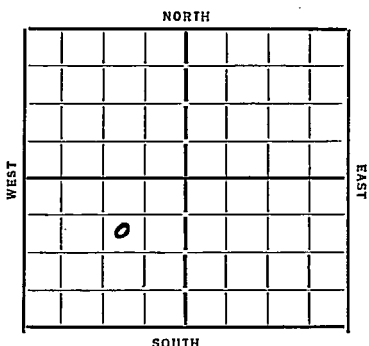

Date 1934

REPORT

6/13 Location
6/21 Spud
6/28 Dlg 1305 12 1/2 1178
7/5 " 1975 10" 1927
7/12 UR 8" 2350
7/19 Dlg 2945 8" 2465
7/26 6" 3187 T Sil 3300-04
Shut 7 Bbls per hr.
8/2 1000 acid Shut 32 Bbls 6 hrs.
8/8 Siliceous 3279 TD 3304
1000 acid 933 Bbls.

COMPLETED

Map No. 49 Sec. 37 Twp. 19 R. 9W **KANSAS**

Well No. 3-2a

Ramsey Pit Company

FIRST REPORT Contractor

SECTION PLAT

	0		

 Ft. from N. Line

1850 Ft. from S. Line

 Ft. from E. Line

1980 Ft. from W. Line

Location ✓

Rig up

Drilling and Remarks:

RECORD

Cased in., ft.

Sand

Gas

Oil

Total Depth

PRODUCTION

1st 24 hrs. Nat.

1st 24 hrs. after shot

Gas Cu. Ft.

Dry Hole

Abandoned

Date

ORVAL MANNSCHRECK

6-13-37 19

Scout

Map No. 49 Sec. 32 Twp. 19 R. 9W

Well No. 3-Pra

Ramsey Pet Company
Contractor

COMPLETED

SECTION PLAT

	0		

 Ft. from N. Line

1850 Ft. from S. Line

 Ft. from E. Line

1980 Ft. from W. Line

Location

Rig up

Drilling and Remarks:

1000 and

933 lbs

RECORD

Cased in., ft.

Sand Silicious 3279

Gas

Oil

Total Depth 3304

PRODUCTION

1st 24 hrs. Nat.

1st 24 hrs. after shot

Gas Cu. Ft.

Dry Hole

Abandoned

Date

8-8-34 19

W. L. NNSCHRECK
Scout