


Rice

Map No. **KANSAS** Sec. *32* Twp. *19* R. *9W*

Well No. *#4 Ira Ramsey Pit.* Farm _____ Company _____

NORTH

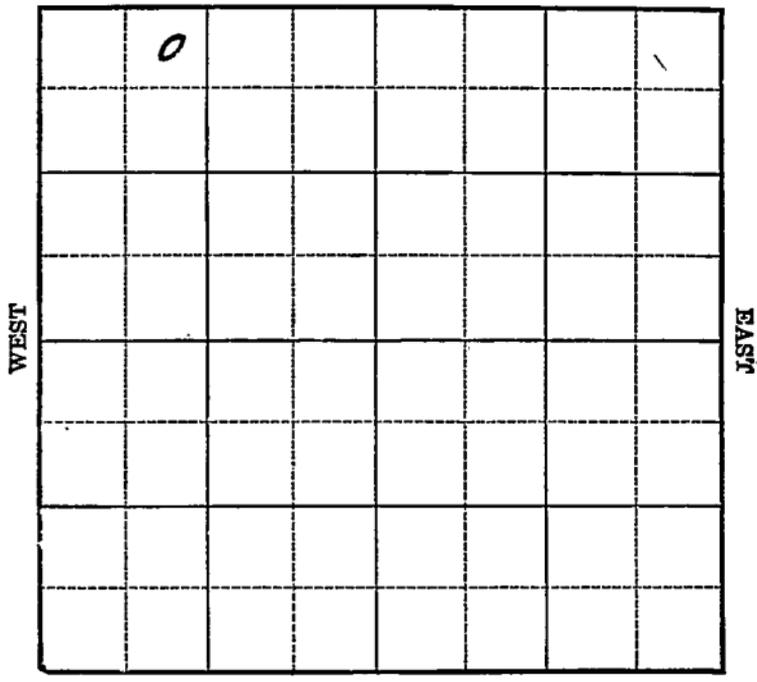

Location _____

Rig Up _____

Drilling Remarks _____

Drilling Remarks _____

RECORD

PRODUCTION

Cased _____ in. _____ ft.

Sand _____

Gas _____

Oil _____

Total Depth _____

1st 24 hrs. Nat. _____

1st 24 hrs. after shot _____

Gas _____ cu. ft.

Dry Hole _____


Abandoned _____

Rice

Map No. _____ Sec. 32 Twp. 19 R. 9W

Well No. #4 Ira Farm _____
Ramsey Pt. Company _____

330 Ft. from N. Line
____ Ft. from S. Line
____ Ft. from E. Line
990 Ft. from W. Line

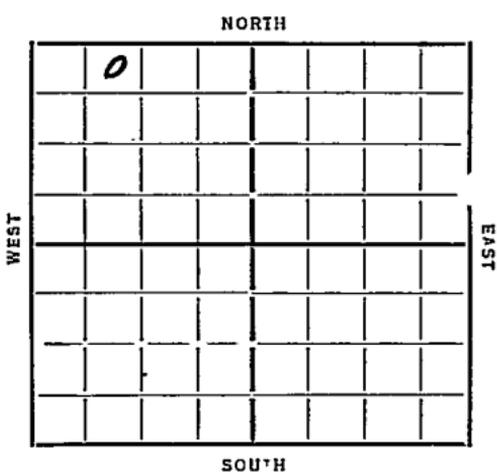

Date 1935

REPORT

2/13 Bldg. Rig
2/21 Rig
2/28 20" 200 C.O.
3/7 Bldg 1103
3/14 _____
3/21 12" 947 Bldg cement
3/28 Bldg 1835
4/4 " 2250
4/11 " 3005 AC 2948
4/18 8" 2270 6" 3181 Sil 3268
Oil 32 76 1/2 T7 3301
1400' oil
4/26 8" 2270 6" 3181 Sil 3268
Oil 32 76 1/2 T7 3301
1400' oil 10 Bbls oil & sw per hr
5/2 _____
5/8 Siliceous 3268 T7 3301
346 Bbls S.W.

COMPLETED

Map No. 49 Sec. 32 Twp. 19 R. 9W

Well No. 4-2ra

Ramsey pt. Company

Contractor

FIRST REPORTS

SECTION PLAT

330 Ft. from N. Line

..... Ft. from S. Line

..... Ft. from E. Line

990 Ft. from W. Line

KANSAS

| | | | |
|---|--|--|--|
| 0 | | | |
| | | | |
| | | | |
| | | | |
| | | | |

Location.....

Rig up.....

Drilling and Remarks:

Beeg Rig

RECORD

Cased..... in., ft.

Sand.....

Gas.....

Oil.....

Total Depth.....

PRODUCTION

1st 24 hrs. Nat.....

1st 24 hrs. after shot.....

Gas..... Cu. Ft.

Dry Hole.....

Abandoned.....

Date

2-13-35

192.....

ORVAL MANNSCHRECK

Scout

Map No. 49 Sec. 32 Twp. 19 R. 9W

Well No. 4-2ra

Ramsay pet Company

Contractor

COMPLETED

SECTION PLAT

| | | | |
|---|--|--|--|
| 0 | | | |
| | | | |
| | | | |
| | | | |
| | | | |

330 Ft. from N. Line

..... Ft. from S. Line

..... Ft. from E. Line

990 Ft. from W. Line

Location.....

Rig up.....

Drilling and Remarks:

346 ft
A. W.

RECORD

Cased..... in., ft.

Sand siliceous 3268

Gas.....

Oil.....

Total Depth 3301

PRODUCTION

1st 24 hrs. Nat.....

1st 24 hrs. after shot.....

Gas..... Cu. Ft.

Dry Hole.....

Abandoned.....

Date

ORVAL MANNSCHRECK

5-8-35 192.....

Scout