


Rice

Form 51-5M-11-31-Palace

Map No. **KANSAS** Sec. 32 Twp. 19 R. 9W

Well No. 1 Lansing Farm
Ramsey Company

NORTH

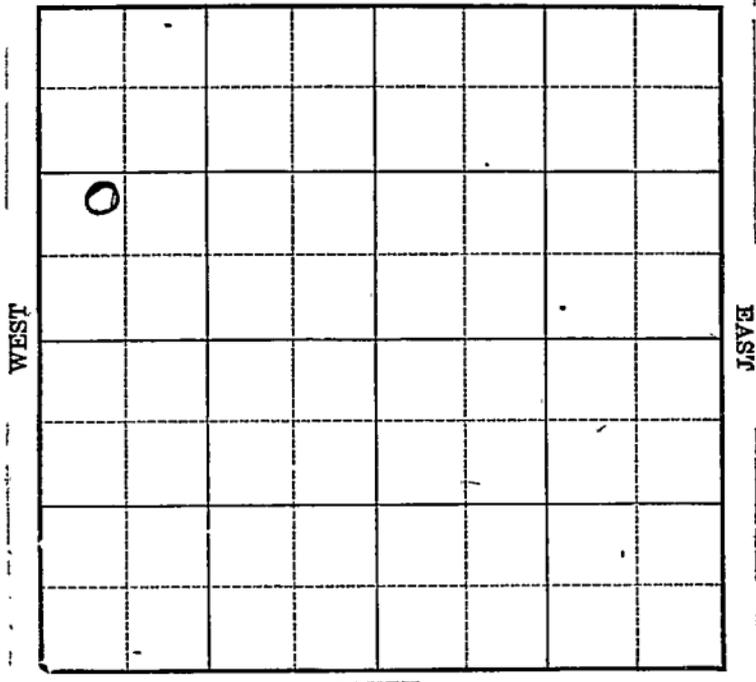

SOUTH

Location _____

Drilling Remarks _____

Rig Up _____

Drilling Remarks _____

RECORD

Cased _____ in. _____ ft.

Sand _____

Gas _____

Oil _____

Total Depth _____

PRODUCTION

1st 24 hrs. Nat. _____

1st 24 hrs. after shot _____

Gas _____ cu. ft.

Dry Hole _____

Abandoned _____

Rice

Map No. KANSAS Sec. 32 Twp 19 R. 9W

Well No. 1 Lansing Farm


Ramsey Company

_____ Ft. from N. Line

1270 Ft. from S. Line

_____ Ft. from E. Line

600 Ft. from W. Line

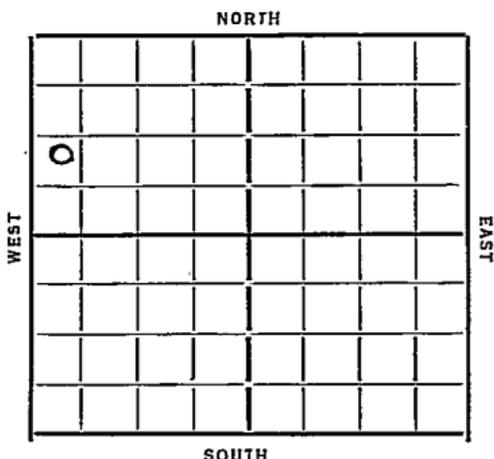

Date 1934

REPORT

<u>3/24</u>	<u>Location</u>
<u>4/5</u>	<u>Rign up</u>
<u>4/12</u>	<u>dly 135</u>
<u>4/19</u>	<u>" 995 20" 190 15" 424</u>
<u>4/26</u>	<u>Run 10" 1915</u>
<u>5/3</u>	<u>TD 2275</u>
<u>5/10</u>	<u>GR 10" 2280</u>
<u>5/18</u>	<u>dly 2300 8" 2240</u>
<u>5/25</u>	<u>" 2920 8" 2282</u>
<u>5/31</u>	<u>" 3182</u>
<u>6/7</u>	<u>Siliceous 3228 TD 3267</u> <u>PB 3251 swab 95 Bbls</u> <u>12 hrs 1000 acid 70 test</u>
<u>6/13</u>	<u>Siliceous 3228 TD 3267</u> <u>1000 acid PB 3251 771 Bbls.</u>

COMPLETED

Map No. 49 Sec. 37 Twp. 19 R. 9W

Well No. 1 - Lansing

Ramsey Company

Contractor

FIRST REPORTS

SECTION PLAT

..... Ft. from N. Line

1270 Ft. from S. Line

..... Ft. from E. Line

600 Ft. from W. Line

●			

Location..... ✓

Rig up.....

Drilling and Remarks:

RECORD

Cased..... in., ft.

Sand.....

Gas.....

Oil.....

Total Depth.....

PRODUCTION

1st 24 hrs. Nat.....

1st 24 hrs. after shot.....

Gas..... Cu. Ft.

Dry Hole.....

Abandoned.....

Date

3-24-34 O. Marnschuch
192 Scott

Map No. 49 Sec. 32 Twp. 19 R. 9W

Well No. 1 - Lansing

Himsey et al Company

Contractor

COMPLETED

SECTION PLAT

X			

_____ Ft. from N. Line

1270 Ft. from S. Line

_____ Ft. from E. Line

660 Ft. from W. Line

Location _____

Rig up _____

Drilling and Remarks:

1000 acid

P.B. 3251

771 RMs

RECORD

Cased _____ in., _____ ft.

Sand Mucous 3228

Gas _____

Oil _____

Total Depth 3267

PRODUCTION

1st 24 hrs. Nat. _____

1st 24 hrs. after shot _____

Gas _____ Cu. Ft.

Dry Hole _____

Abandoned _____

Date

6-13-37 19

ORVAL MANNING Scout