

Rice

Map No. KANSAS Sec. 32 Twp. 19 R. 9W

Well No. #1 Lisk Farm


Gypsy oil Company

330 Ft. from N. Line

_____ Ft. from S. Line

990 Ft. from E. Line

_____ Ft. from W. Line

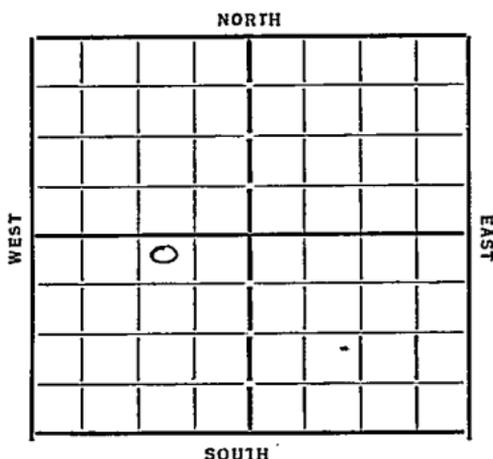

Date
1933

REPORT

9/16 Bldg Reg

9/13 Rigging

9/20 30" - 504 - 15" 338 drly 725

9/29 12" 1540 Nreg 1645

10/5 2185 - reg

10/11 10" 2241 - Nreg 2570

10/18 8" 2890 " 2910

10/25 Silicious 3237 - T.D. 3271 6 at 3237

11/1 Treated with 1000 gals acid

11/8 — 11/15 —

11/22 Silicious 3237 - 3271

1000 gallon acid

247 bbls oil

153 bbls water

Map No. *49* Sec. *32* Twp. *19* R. *9W*

Well No. *#1 Link*

Syzy oil Company

Contractor

SECTION PLAT

	o		

330 Ft. from N. Line

Ft. from S. Line

990 Ft. from E. Line

Ft. from W. Line

FIRST REPORTS

Location.....

Rig up.....

Drilling and Remarks:

B.R.

RECORD

Cased.....in.,ft.

Sand.....

Gas.....

Oil.....

Total Depth.....

PRODUCTION

1st 24 hrs. Nat.....

1st 24 hrs. after shot.....

Gas.....Cu. Ft.

Dry Hole.....

Abandoned.....

Date

9/6/33 *O. Mannsch*

Map No. 49 Sec. 32 Twp. 19 R. 9W

Well No. 1-Link

Gypsy oil Company

Contractor

COMPLETED

SECTION PLAT

330 Ft. from N. Line

..... Ft. from S. Line

990 Ft. from E. Line

..... Ft. from W. Line

	0		

Location.....

Rig up.....

Drilling and Remarks:

1000 gal acid

247 oil
153 water

RECORD

Cased 3 in., 3237 ft.

Sp. Salacious 3237

Gas.....

Oil.....

Total Depth 3271

PRODUCTION

1st 24 hrs. Nat.....

1st 24 hrs. after shot.....

Gas..... Cu. Ft.

Dry Hole.....

Abandoned.....

Date

11-27-33 192 O. Munnick Scout