


Section 32 Township 19 Range 9-W

Well No. 2 - Lisk

Company Torrey & Feaster

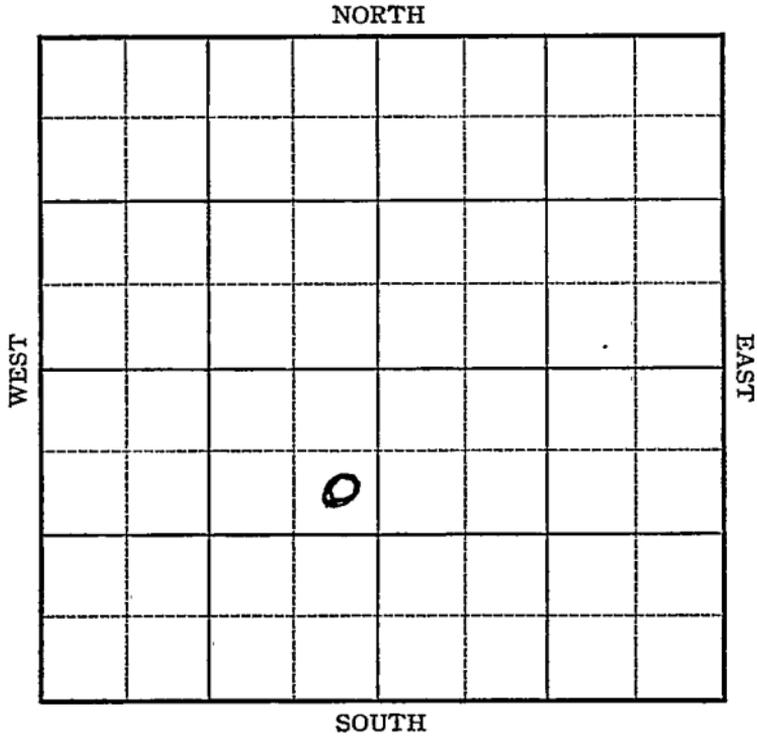



1937

12/15 7" @ 3189'.

5" liner 3220'.

Sil. 3220'.

T.D. 3255'.

4000 acid.

Potential 244 bbls.

COMPLETED

Rice

KANSAS

Map No. \_\_\_\_\_ Sec. 32 Twp. 19 R. 9WWell No. 2 Lisk  
Turrey & Feaster Company**FIRST REPORT**se ne sw

Contractor

50' north of Abd  
hole SECTION PLAT940 Ft. from N. Line

\_\_\_\_\_ Ft. from S. Line

330 Ft. from E. Line

\_\_\_\_\_ Ft. from W. Line


Location \_\_\_\_\_

Rig up \_\_\_\_\_

Drilling and Remarks:

P. U. R**RECORD**

Cased \_\_\_\_\_ in., \_\_\_\_\_ ft.

Sand \_\_\_\_\_

Gas \_\_\_\_\_

Oil \_\_\_\_\_

Total Depth \_\_\_\_\_

**PRODUCTION**

1st 24 hrs. Nat. \_\_\_\_\_

1st 24 hrs. after shot \_\_\_\_\_

Gas \_\_\_\_\_ Cu. Ft.

Dry Hole \_\_\_\_\_


Abandoned \_\_\_\_\_

Date

AUG 25 1937 19H. D. Hatfield

Scout

50 013015 2

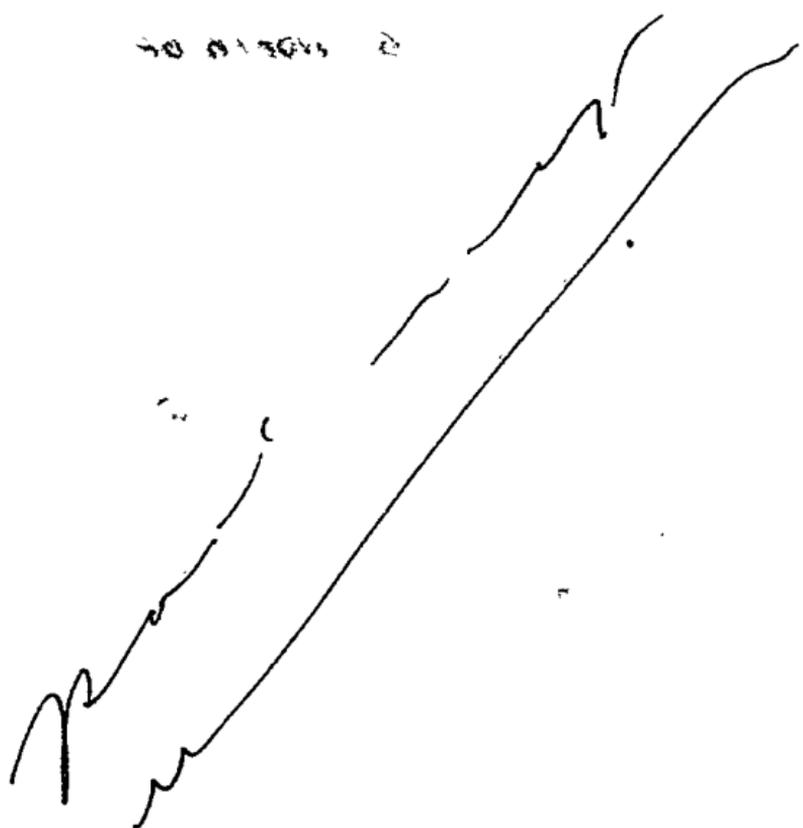

Returned	_____
Cards	_____ <i>Paul</i>
Tracing	_____ <i>John</i>
France Map	_____ <i>C</i>
Scarborough Map	_____ <i>Paul</i>
Moody Map	_____
Scarborough Plat Book	_____
Moody Plat Book	_____

Rice

KANSAS

Map No. 49 Sec. 32 Twp. 19 R. 9WWell No. 2 LiskTorrey & Feaster Company

Contractor

**COMPLETED**

## SECTION PLAT

SE NE SW

940 Ft. from N. Line

\_\_\_\_\_ Ft. from S. Line

330 Ft. from E. Line

\_\_\_\_\_ Ft. from W. Line

		0	

Location \_\_\_\_\_

Rig up \_\_\_\_\_

Drilling and Remarks:

4000 acidPOT - 2447" RECORD 3189Cased 5" Liger in., 3220 ft.Sand 511 3220

Gas \_\_\_\_\_

Oil \_\_\_\_\_

Total Depth 3255

## PRODUCTION

1st 24 hrs. Nat. \_\_\_\_\_

1st 24 hrs. after shot \_\_\_\_\_

Gas \_\_\_\_\_ Cu. Ft.

Dry Hole \_\_\_\_\_

Abandoned \_\_\_\_\_

Date

DEC 15 1937 19H. D. Hatfield Scout.

