Form 51—5M—1-30—38840

Rice

Map No. KANSAS Sec. 32 Twp. 19 R. 9 W

Well No. 6 McGlynn Farm

Gypsy Oil Company

NORTH

WEST

EAST

SOUTH

Location

Drilling Remarks

Rig Up

Drilling Remarks

RECORD

Cased ____ in. ____ ft.

Sand

Gas

Oil

Total Depth

PRODUCTION

1st 24 hrs. Nat.

1st 24 hrs. after shot

Gas ____ cu. ft.

Dry Hole

Abandoned

Rice

Form 252-A
5M 4-32 MPC

KANSAS

Map No. _____ Sec. 32 Twp. 19 R. 9W

Well No. #1 McGlynn Farm

Gypsy Oil Company

~~1080~~ Ft. from N. Line

1020 Ft. from S. Line

_____ Ft. from E. Line

330 Ft. from W. Line

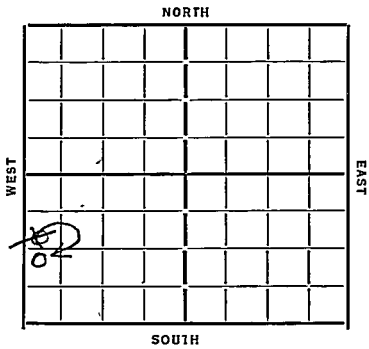

Date	REPORT
1933	
7/12	Bldg Rig
7/19	Rig
7/26	20" - 197 - 15" 320' drlg 6000'
8/2	12" - 1170'
8/9	10" 2075 drlg 2200
8/16	uR 10" 2225 drlg 2710'
8/23	Drlg uR 2880'
8/30	8" 3910' 6" 3219 Siliceous 3212 T.D. 3219
	1800' Oil 1 hour
9/6	Siliceous 3212
	T.D. 3219 750 bbls
	COMPLETED

Form 26—1M Bks.—9-26

KANSAS

Rice

Map No. 49 Sec. 32 Twp. 19 R. 9W

Well No. #1 - McGlynn

Gypsy Oil Company

Contractor

SECTION PLAT

1080 Ft. from N. Line

K.S.C. Ft. from S. Line

Ft. from E. Line

330 Ft. from W. Line

FIRST REPORTS

Location

Rig up

Drilling and Remarks:

B.R.

RECORD

Cased in., ft.

Sand

Gas

Oil

Total Depth

PRODUCTION

1st 24 hrs. Nat.

1st 24 hrs. after shot

Gas Cu. Ft.

Dry Hole

Abandoned

Date

7/13/33 192 Owl Mannschreck Scout

Form 26—1M Bks.—9-26

Map No. 49 Sec. 32 Twp. 19 R. 9W

Well No. 1- McGlynn

Gypsy Company

Contractor

CORRECTION

SECTION PLAT

Ft. from N. Line

1020 Ft. from S. Line

Ft. from E. Line

330 Ft. from W. Line

CORRECTION

Location

Rig up

Drilling and Remarks:

formerly reported 1080' from N. line

RECORD

Cased in., ft.

Sand

Gas

Oil

Total Depth

PRODUCTION

1st 24 hrs. Nat.

1st 24 hrs. after shot

Gas Cu. Ft.

Dry Hole

Abandoned

Date

9/17/33 192 Oval Mannrichsick Scout

Form 26—1M Bks.—9-26

Rice

Map No. 49 Sec. 32 Twp. 19 R. 9W

Well No. 1 McGlynn

Gypsy Company

Contractor

SECTION PLAT

O			

Ft. from N. Line

1020 Ft. from S. Line

Ft. from E. Line

330 Ft. from W. Line

COMPLETED

Location

Rig up

Drilling and Remarks:

750 bbls

RECORD

Cased in., ft.

Sand Subsurface 3212

Gas

Oil

Total Depth 3219

PRODUCTION

1st 24 hrs. Nat.

1st 24 hrs. after shot

Gas Cu. Ft.

Dry Hole

Abandoned

Date

9/6/33 192 P. Mannschreck Scout