

Rice


Form 51-5M-11-31-Palace

Map No. **KANSAS** Sec. **32** Twp. **19** R. **9 W**

Well No. **2 Mc Glyn** Farm

Gypsy Oil Company

NORTH

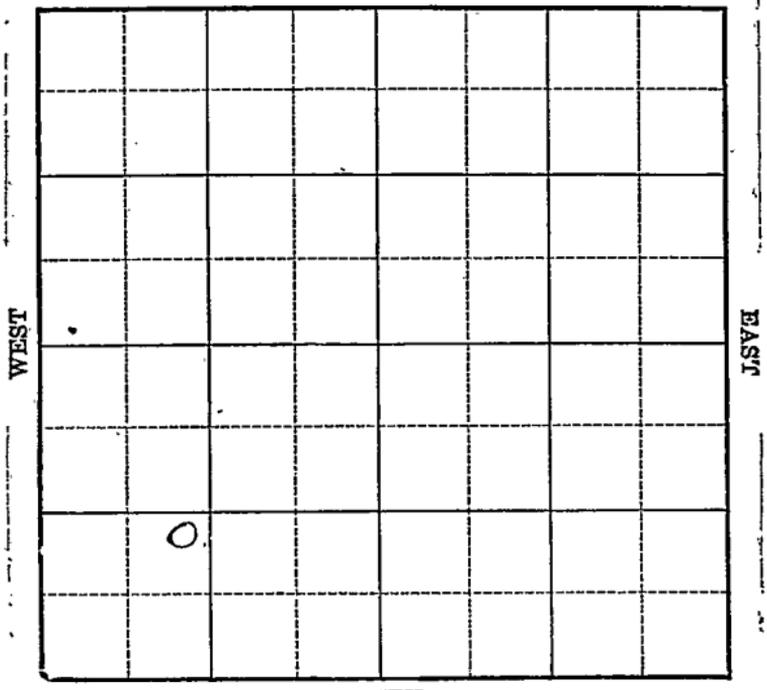

SOUTH

Location _____

Drilling Remarks _____

Rig Up _____

Drilling Remarks _____

RECORD

Cased _____ in. _____ ft.

Sand _____

Gas _____

Oil _____

Total Depth _____

PRODUCTION

1st 24 hrs. Nat. _____

1st 24 hrs. after shot _____

Gas _____ cu. ft.

Dry Hole _____

Abandoned _____

KANSAS

Map No. _____ Sec. 32 Twp 19 R. 9^W

Well No. 2 m^o Glynn Farm _____


Gypsy Oil Company _____

_____ Ft. from N. Line

1039 Ft. from S. Line

_____ Ft. from E. Line

990' Ft. from W. Line

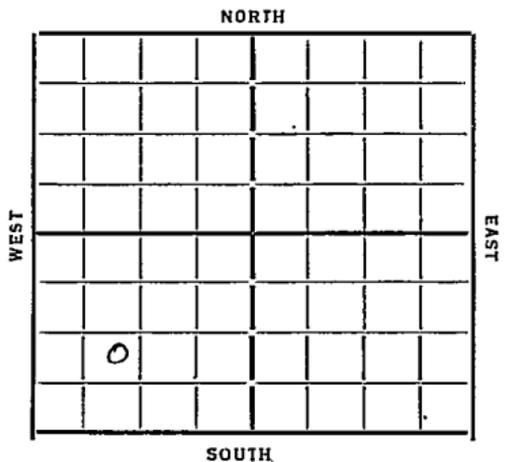

Date 1934

REPORT

1/10 20"-147' - 15 1/2 215' dily 675'
1/17 13" at 1550
1/24 irreg 2275 10" at 2248
1/31 Run 8" 3050
2/7 Cong 3213 T Sil 3251 1st oil
 3269 TD 3278 400 feet oil + water
2/14 1000 Gal acid 700
2/21 Siliceous 3251 TD 3278
 1000 Gal acid 805 Bbls oil
 16 Bbls water.

COMPLETED

Map No. 49 Sec. 32 Twp. 19 R. 9W

Well No. 2-McKlynn

Gypsy Oil Company

Contractor

FIRST REPORTS

SECTION PLAT

Ft. from N. Line

1039 Ft. from S. Line

Ft. from E. Line

990 Ft. from W. Line

Location

Rig up

Drilling and Remarks:

20" 197

15 1/2 315

φ 675

RECORD:

Cased.....in.,ft.

Sand.....

Gas.....

Oil.....

Total Depth.....

PRODUCTION

1st 24 hrs. Nat.....

1st 24 hrs. after shot.....

Gas.....Cu. Ft.

Dry Hole.....

Abandoned.....

Date

1-10-34

192

O. Manscheck Scout

Map No. 49 Sec. 32 Twp. 19 R. 9W

Well No. 2-McLynn

Sydney Oil Company

Contractor

COMPLETED

SECTION PLAT

..... Ft. from N. Line

1039 Ft. from S. Line

..... Ft. from E. Line

990 Ft. from W. Line

RECORD

Location.....

Cased..... in., ft.

Rig up.....

Sand silicious 3251

Drilling and Remarks:

Gas.....

1000 gal acid

Oil.....

505 oil
16 water

Total Depth 3278

PRODUCTION

1st 24 hrs. Nat.....

1st 24 hrs. after shot.....

Gas..... Cu. Ft.

Dry Hole.....

Abandoned.....

Date

2-21-34 192 C. Manschreck Scout