


**KANSAS** Rice

Section 32 Township 19S Range 9W

Well No. #1 Meyers

Company J. C. Dozier

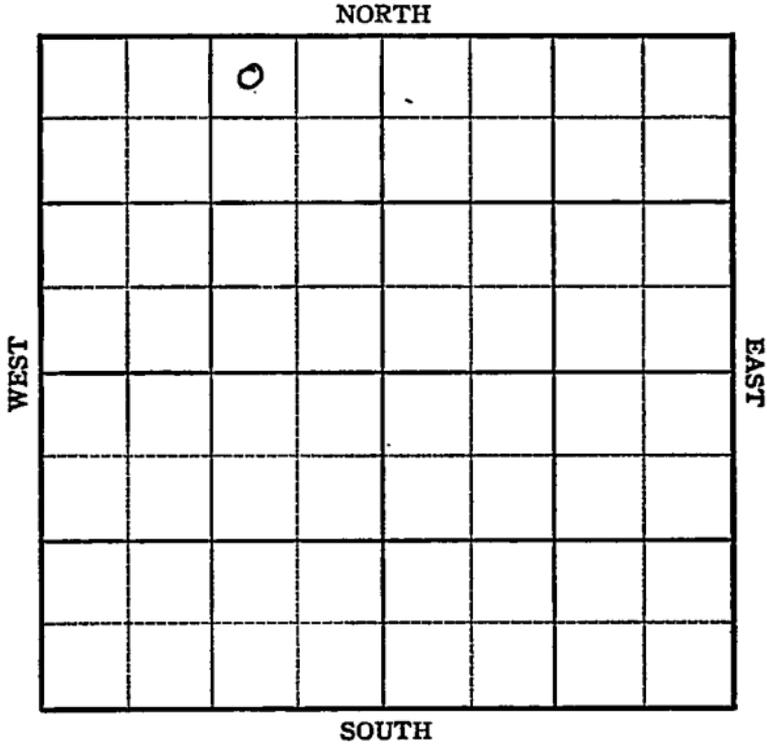

Sec. 32 Twp. 19 R. 9W

Well No. #1 Meyers Farm

J. C. Dozier Company

Chase Pool (Lewis Drlg., Cont.)


330' Ft. from N. Line

         Ft. from S. Line

990' Ft. from E. Line

         Ft. from W. Line

NW NE NW

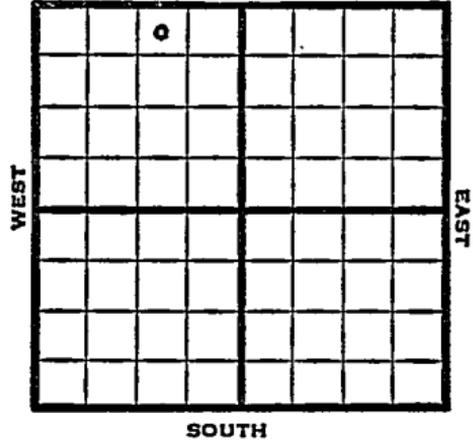

1949	Elev. 1706' REPORT
9/14	8" @ 178' Drlg. 779'
9/21	Arbuckle 3220' TD 3222' 5" @ 3220'
9/28	SO 3231-34 Estm 1 bbl oil PH 5000 acid No help Drlg 3242'
10/5	TD 3246 PB
10/12	"
10/19	"
10/26	"
11/2	TD 3246' Arb. 3220' 5" @ 3220' Aband.
	<b>ABANDONED</b>

Map No. \_\_\_\_\_ Sec. 32 Twp. 19 R. 9W

Well No. 1 Meyers

J. C. Dozier Company

Lewis Drlg. Contractor

NW NE NW

SECTION PLAT

330 Ft. from N. Line

\_\_\_\_\_ Ft. from S. Line

990 Ft. from E. Line

\_\_\_\_\_ Ft. from W. Line

	o		

Rice County

RECORD

Location \_\_\_\_\_

Rig up \_\_\_\_\_

Drilling and Remarks:

8" @ 178

drlg. 779

Cased \_\_\_\_\_ in., \_\_\_\_\_ ft.

Sand \_\_\_\_\_

Gas \_\_\_\_\_

Oil \_\_\_\_\_

Total Depth \_\_\_\_\_

PRODUCTION

1st 24 hrs. Nat. \_\_\_\_\_

1st 24 hrs. after shot \_\_\_\_\_

Gas \_\_\_\_\_ Cu. Ft.

Dry Hole \_\_\_\_\_

Abandoned \_\_\_\_\_

Date

SEP 14 1949 19

S. J. LEWIS Scout

Kansas

Map No. \_\_\_\_\_ Sec. 32 Twp. 19 R. 9W

Well No. 1 Meyers

J. C. Dozier Company

ABANDONED

Contractor

E11706

SECTION PLAT

NW NE NW

330 Ft. from N. Line

Ft. from S. Line

990 Ft. from E. Line

Ft. from W. Line

	6		

Rice County

Location \_\_\_\_\_

Rig up \_\_\_\_\_

Drilling and Remarks:

*CR 8220*

*5" CR 220*

RECORD

Cased \_\_\_\_\_ in., \_\_\_\_\_ ft.

Sand \_\_\_\_\_

Gas \_\_\_\_\_

Oil \_\_\_\_\_

Total Depth *CR 246*

PRODUCTION

1st 24 hrs. Nat. \_\_\_\_\_

1st 24 hrs. after shot \_\_\_\_\_

Gas \_\_\_\_\_ Cu. Ft.

Dry Hole \_\_\_\_\_

Abandoned \_\_\_\_\_

Date

NOV 2 1949 19

S. J. LEWIS Scout