

Section 32 Township 19 Range 9-W

Well No. #1 Meyers "A"

Company J C Dozier Oil
Chase Pool

NORTH

							0

WEST

EAST

SOUTH

Rice

KANSAS

Sec. 32 Twp. 19 R. 9W

Well No. #1 Meyers "A" Farm

J. C. Dozier Oil Company

Lewis Drlg. Contractor

Chase Pool


330' Ft. from N. Line

_____ Ft. from S. Line

330' Ft. from E. Line

_____ Ft. from W. Line

NE/C

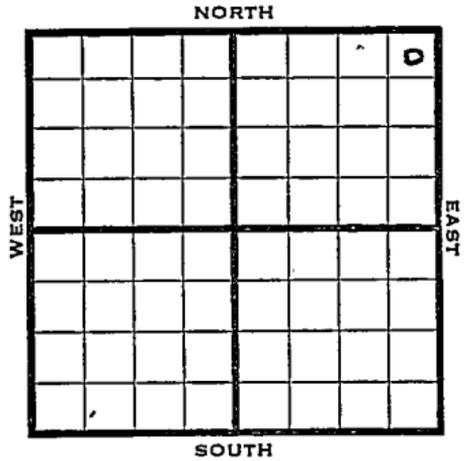

1949	Elev 1710' REPORT
------	-------------------

11/9	8" @ 177' Anhy 328' Drlg. 2485'
11/16	TD 3262' Lansing 2912' A rb. 3225' Aband.

ABANDONED

Map No. _____ Sec. 32 Twp. 19 R. 9W

Well No. 1 Meyers "A"

J. C. Dozier Oil Company

Lewis Drlg. Contractor

NE/C

FIRST REPORT
SECTION PLAT

330 Ft. from N. Line

_____ Ft. from S. Line

330 Ft. from E. Line

_____ Ft. from W. Line

Rice County

Location _____

Rig up _____

Drilling and Remarks:

8" @ 177

Anhy 328

drlg. 2485

RECORD

Cased _____ in., _____ ft.

Sand _____

Gas _____

Oil _____

Total Depth _____

PRODUCTION

1st 24 hrs. Nat. _____

1st 24 hrs. after shot _____

Gas _____ Cu. Ft.

Dry Hole _____

Abandoned _____

Date

NOV 9 1949 19

S. J. LEWIS

Scout

Map No. _____ Sec. 32 Twp. 19 R. 9W

Well No. 1 Meyers "A"

J. C. Dozier Company

ABANDONED

Contractor

NE/C

E11710
SECTION PLAT

330 Ft. from N. Line

_____ Ft. from S. Line

330 Ft. from E. Line

_____ Ft. from W. Line

			6

Rice County

Location _____

Rig up _____

Drilling and Remarks:

*Loss 2912
Cut 3225.*

RECORD

Cased _____ in., _____ ft.

Sand _____

Gas _____

Oil _____

Total Depth 3262

PRODUCTION

1st 24 hrs. Nat. _____

1st 24 hrs. after shot _____

Gas _____ Cu. Ft.

Dry Hole _____

Abandoned _____

Date

NOV 16 1949 19

S. J. LEWIS Scout