


Rice

Form 51-5M-11-31-Palace

Map No. **KANSAS** Sec. 32 Twp. 19 R. 9W

Well No. 2 Rice Farm  
Gypsy oil Company

NORTH

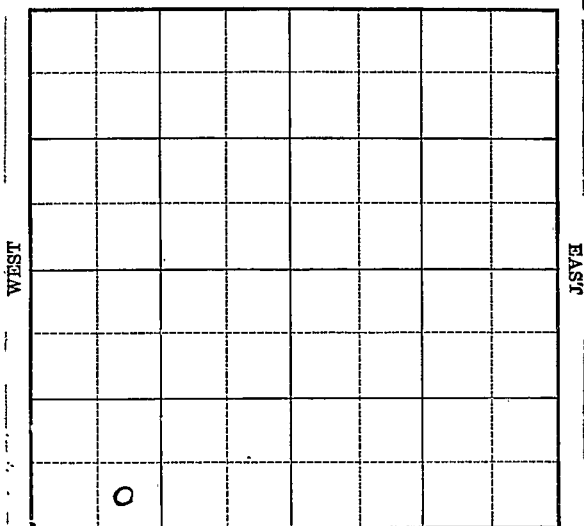

SOUTH

Location \_\_\_\_\_

Drilling Remarks \_\_\_\_\_

\_\_\_\_\_

\_\_\_\_\_

**RECORD**

Cased \_\_\_\_\_ in. \_\_\_\_\_ ft.

Sand \_\_\_\_\_

Gas \_\_\_\_\_

Oil \_\_\_\_\_

Total Depth \_\_\_\_\_

Rig Up \_\_\_\_\_

Drilling Remarks \_\_\_\_\_

\_\_\_\_\_

\_\_\_\_\_

**PRODUCTION**

1st 24 hrs. Nat. \_\_\_\_\_

1st 24 hrs. after shot \_\_\_\_\_

Gas \_\_\_\_\_ cu. ft.

Dry Hole \_\_\_\_\_

Abandoned \_\_\_\_\_

Rice

Map No. KANSAS Sec. 32 Twp. 19 R. 9W

Well No. 2 Rice Farm


Gypsy Oil Company

\_\_\_\_\_ Ft. from N. Line

270 Ft. from S. Line

\_\_\_\_\_ Ft. from E. Line

868 Ft. from W. Line

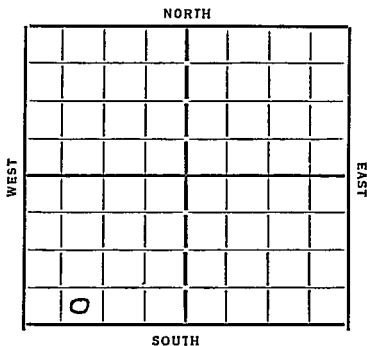

Date  
1934

REPORT

<u>3/14</u>	<u>Rig</u>		
<u>3/22</u>	<u>Drill 290</u>	<u>20"</u>	<u>190</u>
<u>3/29</u>	<u>" 1505</u>		
<u>4/5</u>	<u>" 2045</u>	<u>13"</u>	<u>1547</u>
<u>4/12</u>	<u>" 2285</u>	<u>HFV 2210</u>	<u>10" 2235</u>
<u>4/19</u>	<u>" 2990</u>		
<u>4/26</u>	<u>6" 3239</u>	<u>Cong. 3235</u>	
<u>5/3</u>	<u>Siliceous 3241</u>	<u>TD 3268</u>	
	<u>Level 20 Bbls per hr.</u>		
<u>5/9</u>	<u>Siliceous 3241</u>	<u>TD 3268</u>	
	<u>397 oil</u>		

COMPLETED

Map No. 49 Sec. 32 Twp. 19 R. 9W

Well No. 2- Rife

Gypsy oil Company

Contractor

**FIRST REPORTS**

..... Ft. from N. Line

270 Ft. from S. Line

..... Ft. from E. Line

868 Ft. from W. Line

**SECTION PLAT**


Location.....

Rig up.....

Drilling and Remarks:

Rig

**RECORD**

Cased..... in., ..... ft.

~~Sand~~.....

Gas.....

Oil.....

Total Depth.....

**PRODUCTION**

1st 24 hrs. Nat.....

1st 24 hrs. after shot.....

Gas..... Cu. Ft.

Dry Hole.....

Abandoned.....

Date

3-14-34 192

O. Mansueed Scout

Map No. 49 Sec. 32 Twp. 19 R. 9W

Well No. 2-Rife

Supply oil

Company

Contractor

**COMPLETED**

**SECTION PLAT**


\_\_\_\_\_ Ft. from N. Line

270 Ft. from S. Line

\_\_\_\_\_ Ft. from E. Line

868 Ft. from W. Line

Location \_\_\_\_\_

Rig up \_\_\_\_\_

Drilling and Remarks:

397 oil

**RECORD**

Cased \_\_\_\_\_ in., \_\_\_\_\_ ft.

Sand silicious 3241

Gas \_\_\_\_\_

Oil \_\_\_\_\_

Total Depth 3268

**PRODUCTION**

1st 24 hrs. Nat. \_\_\_\_\_

1st 24 hrs. after shot \_\_\_\_\_

Gas \_\_\_\_\_ Cu. Ft.

Dry Hole \_\_\_\_\_

Abandoned \_\_\_\_\_

Date

5-9-34

19

**ORVAL MANNSCHRECK**

Scout