


Section 32 Township 19 Range 9-W

Well Number #1 Rose

Company Torrey & Feaster

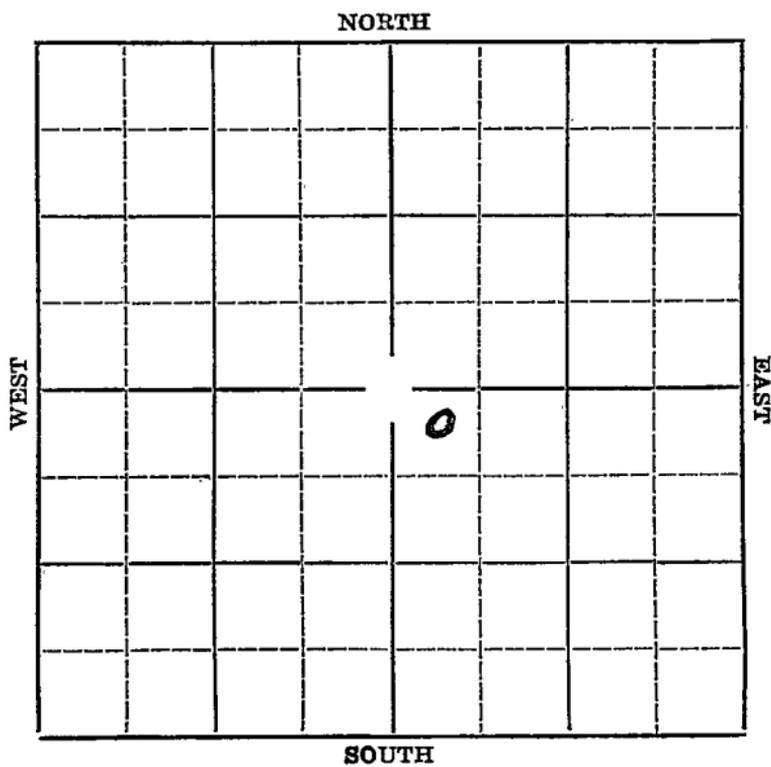

O. W. D. D

Map No. **KANSAS** Sec. **32** Twp. **19** R. **9W**

Well No. **#1 Rose** Farm
Torrey & Feaster Company


330' Ft. from N. Line

_____ Ft. from S. Line

_____ Ft. from E. Line

330' Ft. from W. Line

Elev. 1715

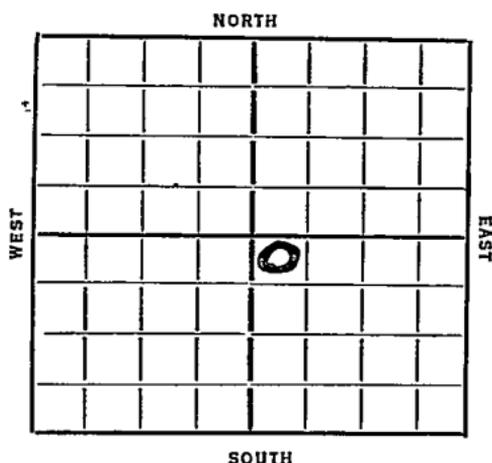

Date **1936** REPORT **O. W. D. D**

7/22 Cellar.
7/30 -- **8/6** -- **8/13** --
8/20 Spud.
8/27 12" @ 291'. Drlg. 840'.
9/3 10" @ 1660'.
9/10 Drlg. 2190'.
9/18 10" @ 1655'. 8" @ 2222'. Dlg. 2625
9/24 Dclg. 2685'.
10/1 2855' fishing.
10/8 Sil. 3220'. Drlg. 3228'. show
of oil.
10/15 T.D. 3230'. Pump 335 bbls of oil
in 19 hours. 1000 acid. No test.
10/21/36 - Sil. 3220'.
T.D. 3230'.
1000 gallons of acid.
579 bbls of oil potential.

COMPLETED

OVER

O. W. D. D

1937

1/6 Old T. D. 3230'.

T. D. 3256'.

Acidize 1500

Potential 1051:

FIRST REPORTS

and

COMPLETED

Map No. 49 Sec. 32 Twp. 19 R. 9W

Well No. 1 Rose

Torrey & Feaster Company
Contractor

SECTION PLAT

330 Ft. from N. Line

_____ Ft. from S. Line

_____ Ft. from E. Line

330 Ft. from W. Line

		0	

FIRST REPORT

Location _____

Rig up _____

Drilling and Remarks:

Ce. Bar.

RECORD

Cased _____ in., _____ ft.

Sand _____

Gas _____

Oil _____

Total Depth _____

PRODUCTION

1st 24 hrs. Nat. _____

1st 24 hrs. after shot _____

Gas _____ Cu. Ft.

Dry Hole _____


Abandoned _____

Date

JUL 22 1936₁₉

S. J. LEWIS

Scout

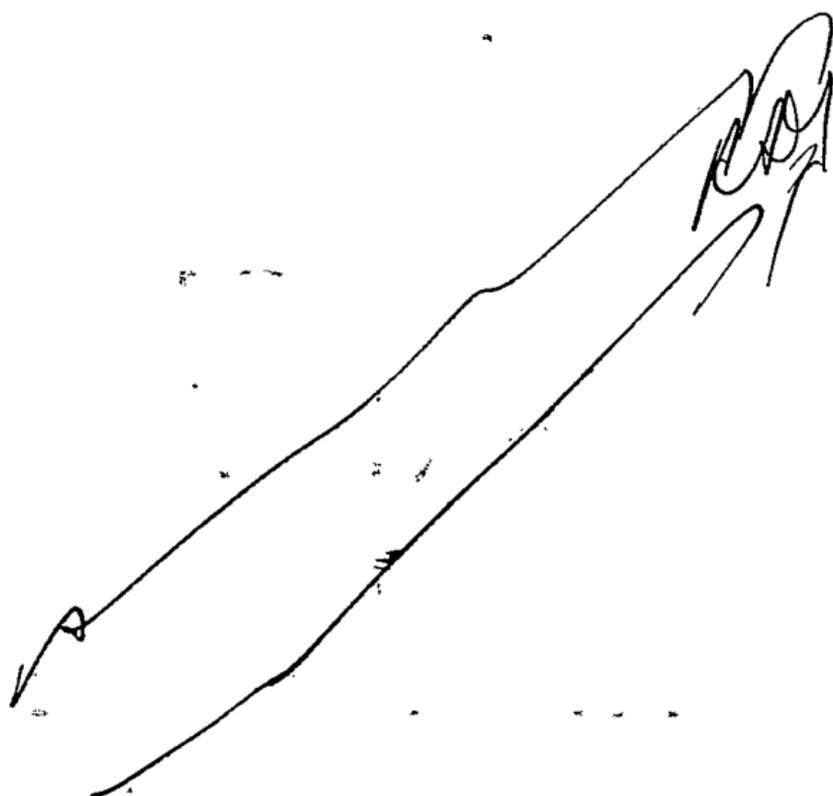

Returned	<i>[Signature]</i>
Cards	<i>[Signature]</i>
Tracing	<i>[Signature]</i>
France Map	<i>[Signature]</i>
Scarborough Map	<i>[Signature]</i>
Moody Map	<i>[Signature]</i>
Scarborough Plat Book	
Moody Plat Book	

KANSASMap No. 49 Sec. 82 Twp. 19 R. 9WWell No. 1 P 22 ETorrey & Feaster Company

Contractor

SECTION PLAT

		0	

330 Ft. from N. Line

_____ Ft. from S. Line

_____ Ft. from E. Line

330 Ft. from W. Line**COMPLETED**

Location _____

Rig up _____

Drilling and Remarks:

S. 132201000 acidP 8579**RECORD**

Cased _____ in., _____ ft.

Sand _____

Gas _____

Oil _____

Total Depth 3230**PRODUCTION**

1st 24 hrs. Nat. _____

1st 24 hrs. after shot _____

Gas _____ Cu. Ft.

Dry Hole _____

Abandoned _____

Date

OCT 21 1936 19

S. J. LEWIS
Scout

[Handwritten signature]

Returned

Cards

Tracing

France Map

Scarborough Map

Moody Map

Scarborough Plat Book

Moody Plat Book

Map No. 49 Sec. 32 Twp. 19 R. 9W.

Well No. 1 Rose

Thorpe & Feather Company

Contractor

SECTION PLAT

		0	

330 Ft. from N. Line

 Ft. from S. Line

 Ft. from E. Line

330 Ft. from W. Line

FIRST REPORT

COMPLETED

OW III

Location _____

Rig up _____

Drilling and Remarks:

Old Y III 230
1500 acid
Po Y 1051

RECORD

Cased _____ in., _____ ft.

Sand _____

Gas _____

Oil _____

Total Depth 3256

PRODUCTION

1st 24 hrs. Nat. _____

1st 24 hrs. after shot _____

Gas _____ Cu. Ft.

Dry Hole _____

Abandoned _____

Date

JAN 6 1937 19

S. J. LEWIS Scout

Paul

Returned
Cards	<i>Paul</i>
Tracing	<i>Paul</i>
France Map
Scarborough Map
Moody Map
Scarborough Plat. Book
Moody Plat. Book