


Rice

KANSAS

Section 32 Township 19 Range 9-W

Well No. 2 - Rose

Company Tarrey & Feaster

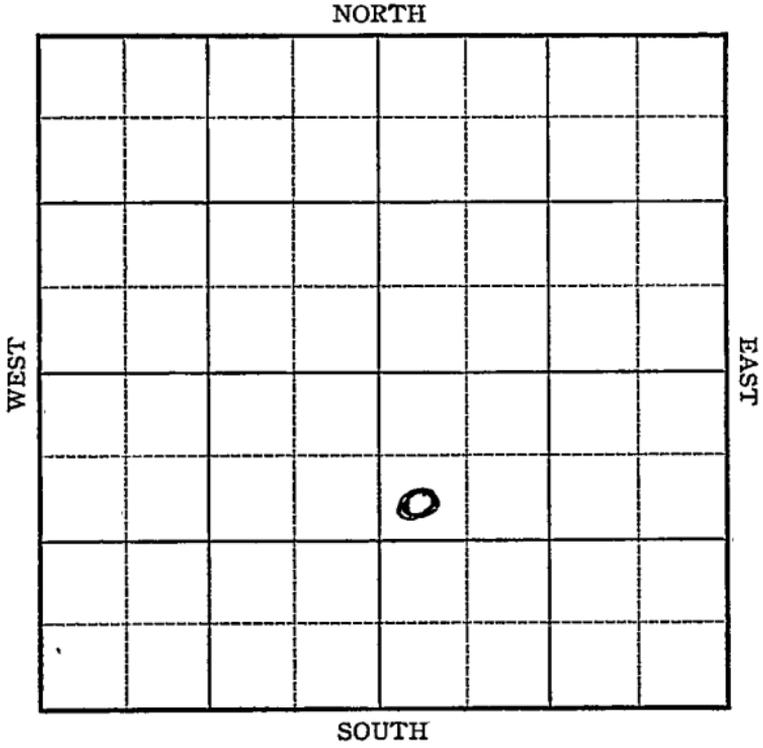

Sec. 32 Twp. 19 R. 9W

Well No. #2 Rose Farm

Tarrey & Feaster Company


SW NW SE

930 Ft. from N. Line

\_\_\_\_\_ Ft. from S. Line

\_\_\_\_\_ Ft. from E. Line

330 Ft. from W. Line

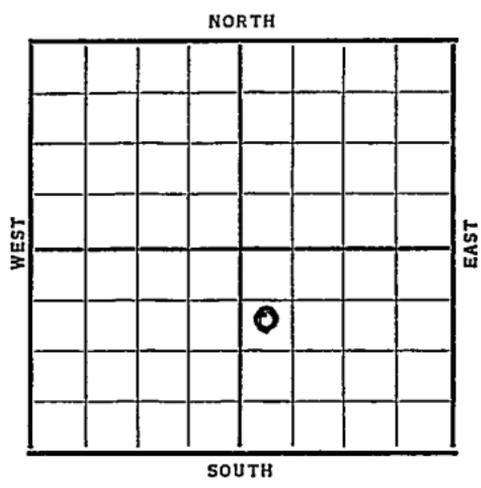

Date	REPORT
1937	
8/25	10" 400', Drlg. 2981'.
9/2	7" @ 3202'. S.O. 3223'. Drlg. 3224'.
9/10	5" liner 3223'. Sil. 3245'. S.O. 3252-56'. T.D. 3257' S.W. P.B. 3250'. 1000 acid.
9/15	7" @ 3202' Sil 3245' TD 3257' P.B. 3250' 1000 acid (would'nt take). D&A
<b>ABANDONED</b>	

*Pine* KANSAS

Map No. \_\_\_\_\_ Sec. 32 Twp. 19 R. 9W

Well No. 2 - Rose

Harrey & Feaster Company

**FIRST REPORT** Contractor

*sw nw se*

**SECTION PLAT**

		0	

930 Ft. from N. Line

\_\_\_\_\_ Ft. from S. Line

\_\_\_\_\_ Ft. from E. Line

330 Ft. from W. Line

Location \_\_\_\_\_

Rig up \_\_\_\_\_

Drilling and Remarks:

*10" - 400*  
*Drlg - 2981*

**RECORD**

Cased \_\_\_\_\_ in., \_\_\_\_\_ ft.

Sand \_\_\_\_\_

Gas \_\_\_\_\_

Oil \_\_\_\_\_

Total Depth \_\_\_\_\_

**PRODUCTION**

1st 24 hrs. Nat. \_\_\_\_\_

1st 24 hrs. after shot \_\_\_\_\_

Gas \_\_\_\_\_ Cu. Ft.

Dry Hole \_\_\_\_\_

Abandoned \_\_\_\_\_

Date

**AUG 25 1937**

19

**H. D. Hatfield**

Scout

Rice KANSAS

Map No. 49 Sec. 32 Twp. 19 R. 9<sup>W</sup>

Well No. 2 - Rose

Torrey & Feaster Company  
Contractor

ABANDONED

SECTION PLAT

		0	

930 Ft. from N. Line

\_\_\_\_\_ Ft. from S. Line

\_\_\_\_\_ Ft. from E. Line

330 Ft. from W. Line

Location \_\_\_\_\_

Rig up \_\_\_\_\_

Drilling and Remarks:

P.B. 3250

1000 Acid (wouldn't take)

DVA

RECORD

Cased 7 in. 3202 ft.

~~Sand~~ 511 3245

Gas \_\_\_\_\_

Oil \_\_\_\_\_

Total Depth 3257

PRODUCTION

1st 24 hrs. Nat. \_\_\_\_\_

1st 24 hrs. after shot \_\_\_\_\_

Gas \_\_\_\_\_ Cu. Ft.

Dry Hole \_\_\_\_\_

Abandoned \_\_\_\_\_

Date

SEP 15 1937 <sub>19</sub>

H. D. Hatfield

Scout